

WATER WELL PLUGGING RECORD Form WWC-5P

KSA 82a-1212

ID NO.

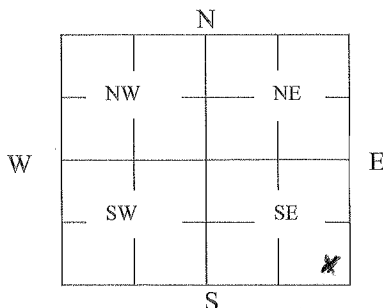
1 LOCATION OF WATER WELL: County: <u>Cheyenne</u>	Fraction $\frac{1}{4}$ $\frac{1}{4}$ <u>SE</u> $\frac{1}{4}$	Section Number <u>25</u>	Township Number <u>2</u>	Range Number <u>38</u> EW
--	---	-----------------------------	-----------------------------	------------------------------

Distance and direction from nearest town or city street address of well if located within city?

6 miles N of Bird City, KS

2 WATER WELL OWNER: <u>Charles KRIBS</u> RR#, St. Address, Box #: <u>2880 ROAD PO 333</u> City, State ZIP Code: <u>Bird City, KS 67731</u>	Global Positioning Systems (decimal degrees, min. of 4 digits) Latitude: _____ Longitude: _____ Elevation: _____ Datum: _____ Data Collection Method: _____
---	--

3 MARK WELL'S LOCATION WITH AN "X" IN SECTION BOX:

4 DEPTH OF WELL 232 ft.WELL'S STATIC WATER LEVEL 10 ft

WELL WAS USED AS:

- 1 Domestic ☒
 2 Irrigation ☐
 3 Feedlot ☐
 4 Industrial ☐

- 5 Public Water Supply ☐
 6 Oil Field Water Supply ☐
 7 Domestic (Lawn & Garden) ☐
 8 Air Conditioning ☐

- 9 Dewatering ☐
 10 Monitoring ☐
 11 Injection Well ☐
 12 Other ☐

Was a chemical/bacteriological sample submitted to Department? Yes ☐ No ☒

5 TYPE OF BLANK CASING USED:

- 1 Steel 3 RMP (SR) 5 Wrought 7 Fiberglass 9 Other (Specify below)
 2 PVC 4 ABS 6 Asbestos-Cement 8 Concrete Tile

Blank casing diameter _____ in. Was casing pulled? Yes ☐ No ☐ If yes, how much _____
 Casing height above or below land surface _____ in.

6 GROUT PLUG MATERIAL: 1 Neat cement 2 Cement grout 3 Bentonite 4 Other _____

Grout Plug Intervals: From _____ ft. to _____ ft., From 10 ft. to 4 ft., From _____ to _____ ft.

What is the nearest source of possible contamination:

- 1 Septic tank 6 Seepage pit 11 Fuel Storage 16 Other (specify below)
 2 Sewer lines 7 Pit privy 12 Fertilizer storage
 3 Watertight sewer lines 8 Sewage lagoon 13 Insecticide storage
 4 Lateral lines 9 Feedyard 14 Abandoned water well Direction from well? _____
 5 Cess pool 10 Livestock pens 15 Oil well/Gas well How many feet? _____

FROM	TO	PLUGGING MATERIALS	FROM	TO	PLUGGING MATERIALS
<u>6</u>	<u>3</u>	<u>Chlorox</u>			
<u>3</u>	<u>222</u>	<u>SAND</u>			
<u>222</u>	<u>TOP</u>	<u>BENTONITE</u>			

7 CONTRACTOR'S OR LANDOWNER'S CERTIFICATION: This water well was plugged under my jurisdiction and was completed on (mo/day/year) 7/11/12 and this record is true to the best of my knowledge and belief. Kansas Water Well Contractor's License No. _____ This Water Well Record was completed on (mo/day/year) _____ under the business name of Ross MFG by (signature) [Signature]

INSTRUCTIONS: Use typewriter or ballpoint pen. Please press firmly and print clearly. Please fill in blanks, underline or circle the correct answers. Send top three copies to Kansas Department of Health and Environment, Bureau of Water, Geology Section, 1000 SW Jackson St., Ste. 420, Topeka, Kansas 66612-1367. Telephone: 785/296-5522. Send one to Water Well Owner and retain one for your records. Visit us at <http://www.kdheks.gov/geo/waterwells>.