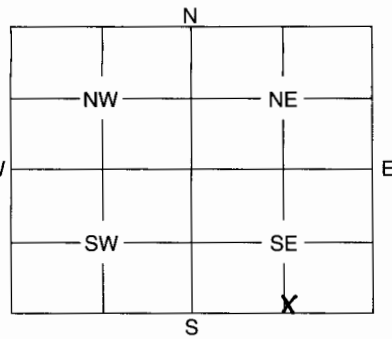


1 LOCATION OF WATER WELL:	Fraction	Section Number	Township Number	Range Number
County: <u>Republic</u>	<u>SE</u> $\frac{1}{4}$ $\frac{1}{4}$ $\frac{1}{4}$	<u>20</u>	<u>2</u>	<u>4</u> E/W

Distance and direction from nearest town or city street address of well if located within city?
Four Miles North of Scandia Ks. 1/4 West North side of Road

2 WATER WELL OWNER: Richard Sandell
P.O. Box 28
 RR #, St. Address, Box #: Republic, KS 66964
 City, State, ZIP Code : _____
 Board of Agriculture, Division of Water Resources
 Application Number: _____

3 MARK WELL'S LOCATION WITH AN "X" IN SECTION BOX: 	4 DEPTH OF WELL <u>21</u> ft. WELL'S STATIC WATER LEVEL <u>7</u> ft. WELL WAS USED AS: <table style="width:100%;"> <tr> <td><input checked="" type="checkbox"/> 1 Domestic</td> <td>5 Public Water Supply</td> <td>9 Dewatering</td> </tr> <tr> <td><input type="checkbox"/> 2 Irrigation</td> <td>6 Oil Field Water Supply</td> <td>10 Monitoring Well</td> </tr> <tr> <td><input type="checkbox"/> 3 Feedlot</td> <td>7 Domestic (Lawn & Garden)</td> <td>11 Injection Well</td> </tr> <tr> <td><input type="checkbox"/> 4 Industrial</td> <td>8 Air Conditioning</td> <td>12 Other</td> </tr> </table> <p>Was a chemical / bacteriological sample submitted to Department? Yes No <input checked="" type="checkbox"/> If yes, mo/day/yr sample was submitted</p> <p>Water Well Disinfected: Yes <input checked="" type="checkbox"/> No</p>	<input checked="" type="checkbox"/> 1 Domestic	5 Public Water Supply	9 Dewatering	<input type="checkbox"/> 2 Irrigation	6 Oil Field Water Supply	10 Monitoring 

5 TYPE OF BLANK CASING USED:

1 Steel	3 RMP (SR)	5 Wrought	7 Fiberglass	<u>9 Other (Specify below)</u>
2 PVC	4 ABS	6 Asbestos-Cement	8 Concrete Tile	<u>Brick</u>

Blank casing diameter 30 in. Was casing pulled? Yes No If yes, how much 4 1/2'
 Casing height above or below land surface 54 in.

6 GROUT PLUG MATERIAL: 1 Neat cement 2 Cement grout 3 Bentonite 4 Other

Grout Plug Intervals: From 4 1/2 ft. to 5 ft., From ft. to ft., From to ft.

What is the nearest source of possible contamination:

1 Septic tank	6 Seepage pit	11 Fuel storage	16 Other (specify below)
2 Sewer lines	7 Pit privy	12 Fertilizer storage
3 Watertight sewer lines	8 Sewage lagoon	13 Insecticide storage
4 Lateral lines	9 Feedyard	14 Abandoned water well
5 Cess pool	10 Livestock pens	15 Oil well/Gas well

Direction from well? How many feet?

FROM	TO	PLUGGING MATERIALS
<u>0</u>	<u>4 1/2</u>	<u>Topsoil</u>
<u>4 1/2</u>	<u>5</u>	<u>Bentonite</u>
<u>5</u>	<u>7</u>	<u>Subsoil</u>
<u>7</u>	<u>21</u>	<u>Gravel</u>

7 CONTRACTOR'S OF LANDOWNER'S CERTIFICATION: This water well was plugged under my jurisdiction and was completed on (mo/day/year) 11/25/06 and this record is true to the best of my knowledge and belief. Kansas Water Well Contractor's License No. This Water Well Record was completed on (mo/day/year) 11/25/06 under the business name of by (signature) Richard L. Sandell

INSTRUCTIONS: Use typewriter or ball point pen. Please press firmly and print clearly. Please fill in blanks, underline or circle the correct answers. Send top three copies to Kansas Department of Health and Environment, Bureau of Water, Geology Section, 1000 SW Jackson St., Ste. 420, Topeka, Kansas 66612-1367. Telephone: 785/296-5522. Send one to Water Well Owner and retain one for your records.