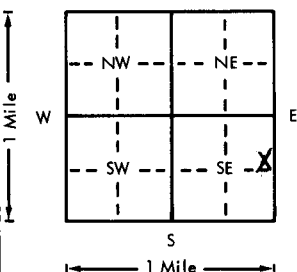
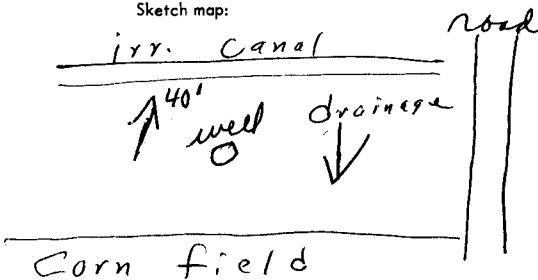


USE TYPEWRITER OR BALL
POINT PEN-PRESS FIRMLY,
PRINT CLEARLY.

WATER WELL RECORD
KSA 82a-1201-1215

Kansas Department of Health and
Environment-Division of Environment
(Water well Contractors)
Topeka, Kansas 66620

1. Location of well:		County <u>Republic</u>	Fraction <u>SE 1/4 NE 1/4 SE 1/4</u>	Section number <u>19</u>	Township number T <u>2</u> S R <u>4</u> E <u>N</u>	Range number
2. Distance and direction from nearest town or city:		<u>4.5 1/2 N</u>		3. Owner of well: <u>Dale Stafford</u>		
Street address of well location if in city:		<u>of Republic KS</u>		R.R. or street: City, state, zip code: <u>Republic KS 66964</u>		
4. Locate with "X" in section below:		Sketch map:		6. Bore hole dia. <u>8</u> in. Completion date <u>8-29-77</u>		
				Well depth <u>50</u> ft.		
5. Type and color of material		From	To	7. <input checked="" type="checkbox"/> Cable tool <input checked="" type="checkbox"/> Rotary <input type="checkbox"/> Driven <input type="checkbox"/> Dug <input type="checkbox"/> Hollow rod <input type="checkbox"/> Jetted <input type="checkbox"/> Bored <input type="checkbox"/> Reverse rotary		
<u>Top soil & clay</u>		<u>0</u>	<u>10</u>	8. Use: <input type="checkbox"/> Domestic <input type="checkbox"/> Public supply <input type="checkbox"/> Industry <input type="checkbox"/> Irrigation <input type="checkbox"/> Air conditioning <input checked="" type="checkbox"/> Stock <input type="checkbox"/> Lawn <input type="checkbox"/> Oil field water <input type="checkbox"/> Other		
<u>Sandy clay</u>		<u>10</u>	<u>33</u>	9. Casing: Material <u>plc</u> Height: <u>above</u> or below Threaded <input type="checkbox"/> Welded <input type="checkbox"/> Surface <u>24</u> in. RMP <u>2</u> PVC <input type="checkbox"/> Weight <u> </u> lbs./ft. Dia. <u>5</u> in. to <u>50</u> ft. depth Wall Thickness: inches or Dia. <u> </u> in. to <u> </u> ft. depth gage No. <u>250</u>		
<u>Clay</u>		<u>33</u>	<u>35</u>	10. Screen: Manufacturer's name <u>Jet-57-cam</u> Type <u>Slotted Plast</u> Dia. <u>5"</u> Slot/gauze <u>0030</u> Length <u>10</u> Set between <u>35</u> ft. and <u>45</u> ft. <u> </u> ft. and <u> </u> ft.		
<u>Sand fine-med w/clay</u>		<u>35</u>	<u>45</u>	Gravel pack? <u>yes</u> Size range of material: <u>fine-3/16</u>		
<u>Shale</u>		<u>45</u>	<u>50</u>	11. Static water level: <u>12</u> ft. below land surface Date <u>8-29-77</u> mo./day/yr.		
				12. Pumping level below land surfaces: <u>17</u> ft. after <u>1</u> hrs. pumping <u>20</u> g.p.m. <u> </u> ft. after <u> </u> hrs. pumping <u> </u> g.p.m. Estimated maximum yield <u>50+</u> g.p.m.		
				13. Water sample submitted: <u> </u> mo./day/yr. Yes <input checked="" type="checkbox"/> No <input type="checkbox"/> Date <u> </u>		
				14. Well head completion: <u> </u> Pitless adapter <u>24</u> inches above grade		
				15. Well grouted? <u>yes</u> With: <u> </u> Neat cement <input checked="" type="checkbox"/> Bentonite <input type="checkbox"/> Concrete <input type="checkbox"/> Depth: From <u>0</u> ft. to <u>10</u> ft.		
				16. Nearest source of possible contamination: ft. <u>40</u> Direction <u>N</u> Type <u>Canal</u> Well disinfected upon completion? <input checked="" type="checkbox"/> Yes <input type="checkbox"/> No		
				17. Pump: <input checked="" type="checkbox"/> Not installed Manufacturer's name <u> </u> Model number <u> </u> HP <u> </u> Volts <u> </u> Length of drop pipe <u> </u> ft. capacity <u> </u> g.p.m. Type: <input type="checkbox"/> Submersible <input type="checkbox"/> Turbine <input type="checkbox"/> Jet <input type="checkbox"/> Reciprocating <input type="checkbox"/> Centrifugal <input type="checkbox"/> Other		
		(Use a second sheet if needed)				
18. Elevation: <u>1485</u>		19. Remarks:		20. Water well contractor's certification: This well was drilled under my jurisdiction and this report is true to the best of my knowledge and belief. <u>MARUHN Well Drilling</u> <u>165</u> Business name License No. Address <u>Red Cloud Ne</u> Signed <u>Leroy Maruhn</u> Date <u>8-30-77</u> Authorized representative		
Topography: <input type="checkbox"/> Hill <input type="checkbox"/> Slope <input type="checkbox"/> Upland <input checked="" type="checkbox"/> Valley						