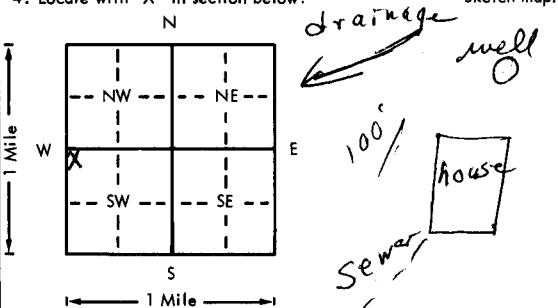


USE TYPEWRITER OR BALL POINT PEN-PRESS FIRMLY, PRINT CLEARLY.

WATER WELL RECORD  
KSA 82a-1201-1215

Kansas Department of Health and Environment-Division of Environment  
(Water well Contractors)  
Topeka, Kansas 66620

1. Location of well:	County <b>Republic</b>	Fraction <b>NW 1/4 NW 1/4 SW 1/4</b>	Section number <b>28</b>	Township number <b>T 2 S R 4 E</b>	Range number <b>4</b>
2. Distance and direction from nearest town or city: <b>3 1/2 N of Scandia KS</b>			3. Owner of well: <b>William Goodwin</b> R.R. or street: <b>2319 Maple Drive</b> City, state, zip code: <b>Bellville KS 66935</b>		
4. Locate with "X" in section below: 			6. Bore hole dia. <b>8</b> in. Completion date <b>8-29-77</b> Well depth <b>70</b> ft.		
5. Type and color of material			7. <input checked="" type="checkbox"/> Cable tool <input checked="" type="checkbox"/> Rotary <input type="checkbox"/> Driven <input type="checkbox"/> Dug <input type="checkbox"/> Hollow rod <input type="checkbox"/> Jetted <input type="checkbox"/> Bored <input type="checkbox"/> Reverse rotary		
Top soil & clay			8. Use: <input checked="" type="checkbox"/> Domestic <input type="checkbox"/> Public supply <input type="checkbox"/> Industry <input type="checkbox"/> Irrigation <input type="checkbox"/> Air conditioning <input type="checkbox"/> Stock <input type="checkbox"/> Lawn <input type="checkbox"/> Oil field water <input type="checkbox"/> Other		
Sandy clay			9. Casing: Material <b>plast</b> Height: <b>(Above)</b> or below Threaded <input type="checkbox"/> Welded <input type="checkbox"/> Surface <b>24</b> in. RMP <input checked="" type="checkbox"/> PVC <input type="checkbox"/> Weight <input type="checkbox"/> lbs./ft. Dia. <b>5</b> in. to <b>70</b> ft. depth Wall Thickness: inches or Dia. <input type="checkbox"/> in. to <input type="checkbox"/> ft. depth Gauge No. <b>250</b>		
Sand w/ rocks & clay			10. Screen: Manufacturer's name <b>Jet Stream</b> Type <b>Slotted Plas</b> Dia. <b>5"</b> Slot/gauze <b>.0030</b> Length <b>16'</b> Set between <b>55</b> ft. end <b>65</b> ft. ft. and <input type="checkbox"/> ft.		
Shale			11. Static water level: <b>43</b> ft. below land surface Date <b>8-29-77</b> mo./day/yr.		
			12. Pumping level below land surfaces: <b>45</b> ft. after <b>1</b> hrs. pumping <b>15</b> g.p.m. ft. after <input type="checkbox"/> hrs. pumping <input type="checkbox"/> g.p.m. Estimated maximum yield <b>25+</b> g.p.m.		
			13. Water sample submitted: <input type="checkbox"/> Yes <input checked="" type="checkbox"/> No Date <input type="checkbox"/>		
			14. Well head completion: <input type="checkbox"/> Pitless adapter <b>24</b> inches above grade		
			15. Well grouted? <b>yes</b> With: <input checked="" type="checkbox"/> Neat cement <input type="checkbox"/> Bentonite <input type="checkbox"/> Concrete Depth: From <b>5</b> ft. to <b>17</b> ft.		
			16. Nearest source of possible contamination: ft. <b>100</b> Direction <b>S</b> Type <b>Sewer</b> Well disinfected upon completion? <input checked="" type="checkbox"/> Yes <input type="checkbox"/> No		
			17. Pump: <input checked="" type="checkbox"/> Not installed Manufacturer's name <input type="checkbox"/> HP <input type="checkbox"/> Volts <input type="checkbox"/> Length of drop pipe <input type="checkbox"/> ft. capacity <input type="checkbox"/> g.p.m. Type: <input type="checkbox"/> Submersible <input type="checkbox"/> Turbine <input type="checkbox"/> Jet <input type="checkbox"/> Reciprocating <input type="checkbox"/> Centrifugal <input type="checkbox"/> Other		
(Use a second sheet if needed)					
18. Elevation: <b>1530'</b>		19. Remarks:		20. Water well contractor's certification: This well was drilled under my jurisdiction and this report is true to the best of my knowledge and belief. <b>MARUHU well Drilling 165</b> Business name License No. Address <b>Rd 1 Cloud Ne 68970</b> Signed <b>Lesay Maruhn</b> Date <b>8-30-77</b> Authorized representative	

T 2  
R 4  
E  
S  
W