


1 LOCATION OF WATER WELL: Fraction SW 1/4 NW 1/4 NW 1/4 Section Number 3 Township Number T 2 S Range Number R 5 E
 County: Republic

Distance and direction from nearest town or city street address of well if located within city?
3W 1/4 S of Republic Ks

2 WATER WELL OWNER: Kent Bouray
 RR#, St. Address, Box #: RT 1 Box 467
 City, State, ZIP Code: Republic KS 66964
 Board of Agriculture, Division of Water Resources
 Application Number:

3 LOCATE WELL'S LOCATION WITH AN "X" IN SECTION BOX:
 4 DEPTH OF COMPLETED WELL: 100 ft. ELEVATION:

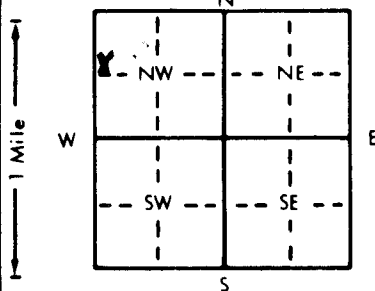

Depth(s) Groundwater Encountered 1. 84 ft. 2. _____ ft. 3. _____ ft.
 WELL'S STATIC WATER LEVEL 84 ft. below land surface measured on 4-9-96 mo/day/yr
 Pump test data: Well water was unknown ft. after bailed hours pumping 6 gpm
 Est. Yield 10 gpm; Well water was _____ ft. after _____ hours pumping _____ gpm
 Bore Hole Diameter: 8 3/4 in. to 25 ft., and 8 in. to 100 ft.
 WELL WATER TO BE USED AS: 5 Public water supply 8 Air conditioning 11 Injection well
 Domestic 3 Feedlot 6 Oil field water supply 9 Dewatering 12 Other (Specify below)
 2 Irrigation 4 Industrial 7 Lawn and garden only 10 Monitoring well
 Was a chemical/bacteriological sample submitted to Department? Yes _____ No If yes, mo/day/yr sample was submitted _____
 Water Well Disinfected? Yes No

5 TYPE OF BLANK CASING USED:
 1 Steel 3 RMP (SR) 5 Wrought iron 8 Concrete tile CASING JOINTS: Glued Clamped _____
 PVC 4 ABS 6 Asbestos-Cement 9 Other (specify below) Welded _____
 7 Fiberglass Threaded _____
 Blank casing diameter 5 in. to 81 ft., Dia 5 in. to 91-100 ft., Dia _____ in. to _____ ft.
 Casing height above land surface 14 in., weight _____ lbs./ft. Wall thickness or gauge No. .214

TYPE OF SCREEN OR PERFORATION MATERIAL:
 1 Steel 3 Stainless steel 5 Fiberglass 8 RMP (SR) 10 Asbestos-cement
 2 Brass 4 Galvanized steel 6 Concrete tile 9 ABS 11 Other (specify) _____
 12 None used (open hole)

SCREEN OR PERFORATION OPENINGS ARE:
 1 Continuous slot 3 Mill slot 5 Gauzed wrapped 6 Wire wrapped 7 Torch cut 9 Drilled holes 11 None (open hole)
 2 Louvered shutter 4 Key punched 10 Other (specify) _____

SCREEN-PERFORATED INTERVALS: From 81 ft. to 91 ft., From _____ ft. to _____ ft.
 From _____ ft. to _____ ft., From _____ ft. to _____ ft.
 GRAVEL PACK INTERVALS: From 25 ft. to 100 ft., From _____ ft. to _____ ft.
 From _____ ft. to _____ ft., From _____ ft. to _____ ft.

6 GROUT MATERIAL: 1 Neat cement 2 Cement grout 3 Bentonite 4 Other Half Plug
 Grout Intervals: From 5 ft. to 25 ft., From 49 ft. to 52 ft., From _____ ft. to _____ ft.

What is the nearest source of possible contamination:
 1 Septic tank Lateral lines To be installed later 7 Pit privy
 2 Sewer lines 5 Cess pool 8 Sewage lagoon 12 Fertilizer storage 16 Other (specify below)
 3 Watertight sewer lines 6 Seepage pit 9 Feedyard 13 Insecticide storage 14 Abandoned water well
 15 Oil well/Gas well

Direction from well? _____ How many feet? _____

FROM	TO	LITHOLOGIC LOG	FROM	TO	PLUGGING INTERVALS
0	19	Top Soil & Clay			
19	25	Sand & clay			
25	30	Clay			
30	35	Sand Med			
35	43	Sand fine			
43	80	Clay			
80	85	Fine Sand & clay			
85	89	Sand & gravel med			
89	100	Shale			

7 CONTRACTOR'S OR LANDOWNER'S CERTIFICATION: This water well was constructed, (2) reconstructed, or (3) plugged under my jurisdiction and was completed on (mo/day/year) 4-9-96 and this record is true to the best of my knowledge and belief. Kansas Water Well Contractor's License No. 165 This Water Well Record was completed on (mo/day/yr) 4-11-96 under the business name of Maruhn Well Drilling by (signature) Ray Maruhn