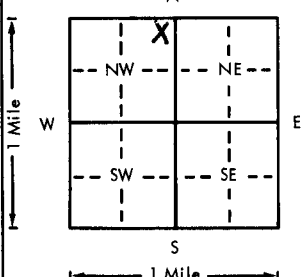


USE TYPEWRITER OR BALL
POINT PEN—PRESS FIRMLY,
PRINT CLEARLY.

WATER WELL RECORD
KSA 82a-1201-1215

Kansas Department of Health and
Environment—Division of Environment
(Water well Contractors)
Topeka, Kansas 66620

1. Location of well:		County <u>Republic</u>	Fraction <u>NE 1/4 NE 1/4 NW 1/4</u>	Section number <u>2</u>	Township number T <u>2</u> S R <u>5</u> E <u>W</u>	Range number
2. Distance and direction from nearest town or city: <u>1/2 S - 1 W</u> Street address of well location if in city: <u>of Republic, Ks</u>		3. Owner of well: <u>Darrell Birrell</u> R.R. or street: <u>#1</u> City, state, zip code: <u>Republic, Kansas 66964</u>				
4. Locate with "X" in section below: 		Sketch map:		6. Bore hole dia. <u>8</u> in. Completion date <u>4-11-78</u> Well depth <u>27</u> ft.		
5. Type and color of material		From	To	7. Cable tool <input checked="" type="checkbox"/> Rotary <input type="checkbox"/> Driven <input type="checkbox"/> Dug <input type="checkbox"/> Hollow rod <input type="checkbox"/> Jetted <input type="checkbox"/> Bored <input type="checkbox"/> Reverse rotary		
<u>top soil</u>		<u>0</u>	<u>5</u>	8. Use: <input checked="" type="checkbox"/> Domestic <input type="checkbox"/> Public supply <input type="checkbox"/> Industry <input type="checkbox"/> Irrigation <input type="checkbox"/> Air conditioning <input type="checkbox"/> Stock <input type="checkbox"/> Lawn <input type="checkbox"/> Oil field water <input type="checkbox"/> Other		
<u>sand</u>		<u>5</u>	<u>15</u>	9. Casing: Material <u>PVC</u> Height: Above or below Threaded <input type="checkbox"/> Welded <input checked="" type="checkbox"/> Surface <u>1</u> in. RMP <input type="checkbox"/> PVC <input checked="" type="checkbox"/> Weight <u>3</u> lbs./ft. Dia. <u>5</u> in. to <u>27</u> ft. depth Wall Thickness: inches or Dia. <u>5</u> in. to <u>27</u> ft. depth gage No. <u>1258</u>		
<u>fine gravel</u>		<u>15</u>	<u>27</u>	10. Screen: Manufacturer's name <u>Pumper Supply</u> Type <u>PVC</u> Dia. <u>5</u> Slot/gauge <u>1/16"</u> Length <u>10</u> Set between <u>17</u> ft. and <u>27</u> ft. ft. and <u>27</u> ft.		
<u>rock</u>		<u>27</u>		Gravel pack? <u>YES</u> Size range of material <u>1/8-1/2</u>		
				11. Static water level: <u>8</u> ft. below land surface Date <u>4-11-78</u> mo./day/yr.		
				12. Pumping level below land surfaces: <u>25</u> ft. after <u>1/2</u> hrs. pumping <u>15</u> g.p.m. ft. after <u> </u> hrs. pumping <u> </u> g.p.m. Estimated maximum yield <u>20</u> g.p.m.		
				13. Water sample submitted: <u> </u> mo./day/yr. Yes <input checked="" type="checkbox"/> No <input type="checkbox"/> Date <u> </u>		
				14. Well head completion: <u> </u> Pitless adapter <u>12</u> inches above grade		
				15. Well grouted? <u>YES</u> With: <u> </u> Neat cement <u> </u> Bentonite <input checked="" type="checkbox"/> Concrete <u> </u> Depth: From <u>0</u> ft. to <u>10</u> ft.		
				16. Nearest source of possible contamination: <u>NONE</u> ft. <u> </u> Direction <u> </u> Type <u> </u> Well disinfected upon completion? <input checked="" type="checkbox"/> Yes <input type="checkbox"/> No		
				17. Pump: <input checked="" type="checkbox"/> Not installed Manufacturer's name <u> </u> Model number <u> </u> HP <u> </u> Volts <u> </u> Length of drop pipe <u> </u> ft. capacity <u> </u> g.p.m. Type: <u> </u> Submersible <u> </u> Turbine <u> </u> Jet <u> </u> Reciprocating <u> </u> Centrifugal <u> </u> Other		
				(Use a second sheet if needed)		
18. Elevation: <u>1475</u> Topography: <u> </u> Hill <u> </u> Slope <u> </u> Upland <input checked="" type="checkbox"/> Valley		19. Remarks:		20. Water well contractor's certification: This well was drilled under my jurisdiction and this report is true to the best of my knowledge and belief. <u>361</u> <u>COX-BESWICK IRRIGATION SERVICE, INC.</u> Business name <u>Clifton Ximenes</u> License No. <u>66937</u> Address <u> </u> Signed <u>Thomas Cox</u> Date <u>5-2-78</u> Authorized representative		