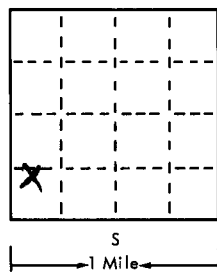
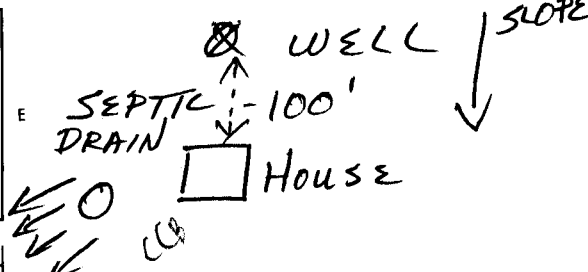


USE TYPEWRITER OR BALL
POINT PEN-PRESS FIRMLY,
PRINT CLEARLY.

WATER WELL RECORD
KSA 82a-1201-1215

T R EW sec 1/4 1/4 1/4 No.

Kansas State Dept. Of Health
(Water Well Contractors)
Forbes-Bldg. 740
Topeka, Kansas 66620

1 Location of well:		County REPUBLIC	Township name WHITEROCK	Fraction SE 1/4 SE 1/4	Section number 14	Town number T2 S	Range number R5 # W		
Distance and direction from nearest town or city: 4 W-S N 1/2 E				3 Owner of well: ALAN WEIR					
Street address of well location if in city: NORTH SIDE OF SCANDIA				Address: COURTLAND, KANS					
Locate with "X" in section below: N 		Sketch map: 		4 Well depth: 63 ft. Date of completion 11/3/75 Well diameter 8 in.					
2		Type and color of material		From		To		5 <input type="checkbox"/> Cable tool <input checked="" type="checkbox"/> Rotary <input type="checkbox"/> Driven <input type="checkbox"/> Dug <input type="checkbox"/> Hollow rod <input type="checkbox"/> Jetted <input type="checkbox"/> Bored <input type="checkbox"/> Reverse rotary	
								6 Use: <input checked="" type="checkbox"/> Domestic <input type="checkbox"/> Public supply <input type="checkbox"/> Industry <input type="checkbox"/> Irrigation <input type="checkbox"/> Air conditioning <input type="checkbox"/> Commercial <input type="checkbox"/> Test well <input type="checkbox"/>	
								7 Casing: Material PIK Height above below Threaded <input type="checkbox"/> Welded <input checked="" type="checkbox"/> Surface 18 in. Diam. 5 in. to 63 ft. depth Drive shoe? <input type="checkbox"/> Yes <input checked="" type="checkbox"/> No _____ in. to _____ ft. depth	
								8 Screen: Manufacturer CERTAINTEED Type PIK Dia. 5" Slot gauge 1/16" Length 20' Set between 63 ft. and 43 ft. Fittings: Gravel pack <input checked="" type="checkbox"/> Yes <input type="checkbox"/> No Size range of material 8x1/4"	
								9 Static water level: 35 ft. below land surface Date 11/3/75	
								10 Pumping level below land surfaces: _____ ft. after _____ hrs. pumping _____ g.p.m. _____ ft. after _____ hrs. pumping _____ g.p.m. Estimated maximum yield 5 g.p.m.	
								11 Water sample submitted: <input type="checkbox"/> Yes <input checked="" type="checkbox"/> No Date _____	
								12 Well head completion: <input type="checkbox"/> Pitless adapter <input checked="" type="checkbox"/> Inches above grade	
								13 Well grouted? <input checked="" type="checkbox"/> Yes <input type="checkbox"/> No <input checked="" type="checkbox"/> Neat cement <input type="checkbox"/> Bentonite <input type="checkbox"/> Depth: From 0 ft. to 10 ft.	
								14 Nearest source of possible contamination: ft. 100 Direction SOUTH Type SEPTIC Well disinfected upon completion? <input checked="" type="checkbox"/> Yes <input type="checkbox"/> No	
								15 Pump: <input checked="" type="checkbox"/> Not installed Manufacturer's name _____ Model number _____ HP _____ Volts _____ Length of drop pipe _____ ft. capacity _____ g.m.p. Type: <input type="checkbox"/> Submersible <input type="checkbox"/> Turbine <input type="checkbox"/> Jet <input type="checkbox"/> Reciprocating <input type="checkbox"/> Centrifugal <input type="checkbox"/> Other	
16 Remarks: elevation 1510' Topography: <input type="checkbox"/> Hill <input type="checkbox"/> Slope <input checked="" type="checkbox"/> Upland <input type="checkbox"/> Valley								17 Water well contractor's certification: This well was drilled under my jurisdiction and this report is true to the best of my knowledge and belief. GEO COX & SONS INC 358 Business name _____ License No. _____ Address CHETON, KANS Signed Wayne Cox Date 11/25/75 Authorized representative	