


1 LOCATION OF WATER WELL: County: Republic Fraction: NW 1/4 NE 1/4 NE 1/4 Section Number: 25 Township Number: T 2 S Range Number: R 6 E/W

Distance and direction from nearest town or city street address of well if located within city?
4 1/2 Miles south of Republic 1/4 West South Side of Road

2 WATER WELL OWNER: Brian H Rosene Vera Rosene
 RR#, St. Address, Box #: 1270 Dexter 2825 Pattie Wicklitz Ks.
 City, State, ZIP Code: Denver Co. Board of Agriculture, Division of Water Resources
 Application Number:

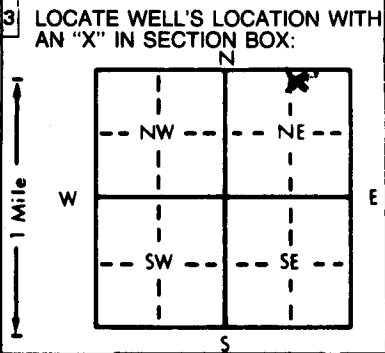

4 DEPTH OF COMPLETED WELL: 27' ft. ELEVATION:
 Depth(s) Groundwater Encountered 1. 21' ft. 2. ft. 3. ft.
 WELL'S STATIC WATER LEVEL 21' ft. below land surface measured on mo/day/yr
 Pump test data: Well water was ft. after hours pumping gpm
 Est. Yield 5-10 gpm: Well water was ft. after hours pumping gpm
 Bore Hole Diameter: 1 1/2 in. to ft., and in. to ft.
 WELL WATER TO BE USED AS:
 1 Domestic 3 Feedlot 6 Oil field water supply 9 Dewatering 12 Other (Specify below)
 2 Irrigation 4 Industrial 7 Lawn and garden only 10 Monitoring well
 Was a chemical/bacteriological sample submitted to Department? Yes.....No.....; If yes, mo/day/yr sample was submitted
 Water Well Disinfected? Yes No

5 TYPE OF BLANK CASING USED:
 Steel 3 RMP (SR) 5 Wrought iron 8 Concrete tile CASING JOINTS: Glued Clamped
 2 PVC 4 ABS 7 Fiberglass Welded
 Blank casing diameter 7 1/2 in. to ft., Dia. in. to ft., Dia. in. to ft.
 Casing height above land surface In Pit in., weight lbs./ft. Wall thickness or gauge No.
 TYPE OF SCREEN OR PERFORATION MATERIAL:
 1 Steel 3 Stainless steel 5 Fiberglass 7 PVC 10 Asbestos-cement
 2 Brass 4 Galvanized steel 6 Concrete tile 8 RMP (SR) 11 Other (specify) Driven Sand Pit
 12 None used (open hole)
 SCREEN OR PERFORATION OPENINGS ARE:
 1 Continuous slot 3 Mill slot 5 Gauzed wrapped 8 Saw cut 11 None (open hole)
 2 Louvered shutter 4 Key punched 6 Wire wrapped 9 Drilled holes
 7 Torch cut 10 Other (specify) Unknown
 SCREEN-PERFORATED INTERVALS: From ft. to ft., From ft. to ft.
 GRAVEL PACK INTERVALS: From ft. to ft., From ft. to ft.

6 GROUT MATERIAL: 1 Neat cement 2 Cement grout 3 Bentonite 4 Other
 Grout Intervals: From ft. to ft., From ft. to 27' ft., From ft. to ft.
 What is the nearest source of possible contamination:
 1 Septic tank 4 Lateral lines 7 Pit privy 10 Livestock pens 14 Abandoned water well
 2 Sewer lines 5 Cess pool 8 Sewage lagoon 11 Fuel storage 15 Oil well/Gas well
 3 Watertight sewer lines 6 Seepage pit 9 Feedyard 12 Fertilizer storage 16 Other (specify below) None
 13 Insecticide storage

Direction from well? How many feet?

FROM	TO	LITHOLOGIC LOG	FROM	TO	PLUGGING INTERVALS
			0	6'	Pit for Pressure tank to another well.
			6'	27'	Bentonite Plug
					Well was treated with Chlorine Tablets prior to Plugging.
					E.P.A. Reg. No 50510-1

7 CONTRACTOR'S OR LANDOWNER'S CERTIFICATION: This water well was (1) constructed, (2) reconstructed, or (3) plugged under my jurisdiction and was completed on (mo/day/year) 4-24-92 and this record is true to the best of my knowledge and belief. Kansas
 Water Well Contractor's License No. Tenant of Farm This Water Well Record was completed on (mo/day/yr) 4-24-92
 under the business name of Tenant of Farm by (signature) Richard L. Sandell