•		14//	ATER WELL RI	ECOBD	Form WWC	E VCA 00	?a-1212	ID No.					
		TER WELL:	Fraction		Politi WWC		Section Num		Towr	nship Nun	nber	Range Nu	umber
County:				14 NE		1/4	32		T	4	S	R 6	3 /W)
		from nearest to		0		_	116	ease	See	atta	iched	map	
2 WATER	WELL OW	NER: Burlin	ston North	hern de	intere l	Gilway C	9.					1.44	
RR#, St. Ad City, State,		# :4515	Kansas	NC 1	Lin					rd of Agrid	,	vision of Water	Resources
		CATION WITH	4 DEPTH OF	COMPLE	76 / 146 TED WELL	18	ft. EL	EVATION					
	SECTION		Depth(s) Gro	oundwater	Encountered								
	ı	1	WELL'S STA 	TIC WATE	R LEVEL' data: Well w	4ft. bater was	elow land s	urface ft. aft	measured er	on mo/d	lay/yr! . hours pu	(41.41.ex	apm
	NW-X-	- NE	Est. Yield	. <u></u> ç	gpm: Well water wasft. after hours pumping								
	1	!	1 Domes	stic 3 l	3 Feedlot 6 Oil field water supply 9 Dewatering 12 Other (Specify below)								
W I E 2 Irrigation 4 Industrial 7 Domestic (lawn & garden) 10 Monitoring well										•••••			
	·sw	- SE	Was a chem	ical/bacteri	ological samp	le submitted	to Departme	ent? Yes	s No	X	If ves. me	o/dav/vrs sampl	e was sub-
		1	mitted		bacteriological sample submitted to Department? Yes No; If yes, mo/day/yrs sam Water Well Disinfected? Yes								lo X
	S												
5 TYPE OF BLANK CASING USED: 1 Steel 3 RMP (SR)					ught iron estos-Cement		8 Concrete tile 9 Other (specify below)		CASI	NG JOIN		l Clampo ed	
2 PVC 4 ABS Blank casing diameterin. to				7 Fibe							Threadedin. toft.		
Blank casin	g diameter tht above la	nd surface	in. to . 3 6		ft., Dia weight	Sc4. 40	in. to .	Ib	s./ft. Wall	.ft., Dia thickness	s or guage	in. to	ft.
Casing height above land surface						T	Þνc			10 Asbestos-Cement			
					5 Fiberglass 8 6 Concrete tile 9			` '			11 Other (Specify)		
		RATION OPENII				uazed wrappe	ed		8 Saw c			11 None (oper	n hole)
1 Continuous slot 3Mill slot						ire wrapped orch cut	9 Drille						ft
	ered shutter	r	(ey punched : From	8		_	ft F					_	
			From		ft. to .	····	ft., F	rom	<u> </u>		ft. to		ft.
٦	HAVEL PAG	CK INTERVALS	From		π. το . ft. to .		rt., r ft., f	-rom - rom		-	π. το . ft. to .		π. ft.
6 GROU	T MATERIA	I · 1 Nea	at cement	2 C	ement grout	⊘ B	entonite	4	Other				
Grout Interv											ft. toft.		
		irce of possible		ղ:				10 Livestock pens			14 Abandoned water well		
1 Septic tank 4 Lateral lines 2 Sewer lines 5 Cess pool					7 Pit pri 8 Sewa	vy ge lagoon	Fuel st		storage zer storage			15 Oil well/Gas well16 Other (specify below)	
3 Watertight sewer lines 6 Seepage pit					9 Feedy		13 Insecticide						
Direction fro	-		UT1101.01	210100	5001			How many feet?				FED. (AL O	
FROM	10 18	Silty cl	LITHOLOG	aic Log		FROM	ТО	-		PLUG	GING IN	TERVALS	-
	70	7/11/9 (1	7										
								_					
								-					
								-					
					_								
Z CONTRA	ACTOR'S O	R LANDOWNE	R'S CERTIFIC	CATION: T	his water wel	was 1) con	structed, (2)	recons	structed,	or (3) plu	gged und	er my jurisdiction	on and was
Completed o	n (mo/day/y Contractor's	ear)	1, 1, 1, U,	710	This Wa	ter Well Reco	and th	nis reco	ord is true	to the bes av/vr)	t of my kno	owledge and be	ief. Kansas
under the bu	usiness nam	ne of Solo	w Gran	. md <	Sur Pa	. In	(by (sig	gnature)	11/	2.1	1/05°	

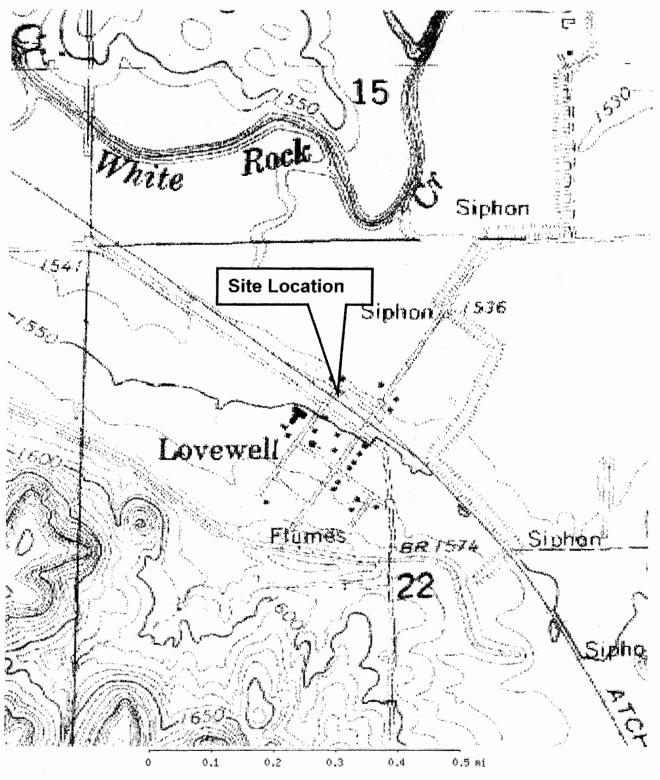


Figure 1

BNSF Leased Property 155411-Harlow Watson Lovewell, Kansas

