


MW-3

WATER WELL PLUGGING RECORD Form WWC-5P KSA 82a-1212 ID NO.

1 LOCATION OF WATER WELL: Fraction 1/4 SE 1/4 NE 1/4 NW 1/4 Section Number 22 Township Number T 2 S Range Number 6 E W

Street/Rural Address of Well Location; if unknown, distance & direction from nearest town or intersection: RR Depot in Lawrence, KS Global Positioning Systems (GPS) information: Latitude: 39.8675 Longitude: 97.9812

2 WATER WELL OWNER: BNSF Railway Co. RR#, St. Address, Box #: 4515 Kansas Ave. City, State ZIP Code: Kansas City KS 66106

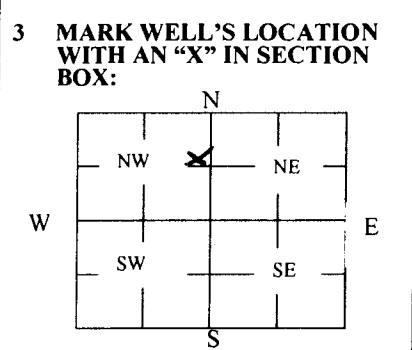

4 DEPTH OF WELL 16 ft. WELL'S STATIC WATER LEVEL ft. WELL WAS USED AS: Domestic Irrigation Feedlot Industrial Public Water Supply Oil Field Water Supply Domestic (Lawn & Garden) Air Conditioning Dewatering Monitoring Injection Well Other

5 TYPE OF BLANK CASING USED: Steel PVC, RMP (SR) ABS, Wrought Asbestos-Cement, Fiberglass Concrete Tile, Other. Blank casing diameter 2 in. Was casing pulled? Yes. Casing height above or below land surface -5.04 in.

6 GROUT PLUG MATERIAL: Neat cement, Cement grout, Bentonite, Other. Grout Plug Intervals: From 2 ft. to 16 ft., From - ft. to - ft., From - to - ft.

What is the nearest source of possible contamination: Septic tank, Sewer lines, Watertight sewer lines, Lateral lines, Cess pool, Seepage pit, Pit privy, Sewage lagoon, Feedyard, Livestock pens, Fuel Storage, Fertilizer storage, Insecticide storage, Abandoned water well, Oil well/Gas well, Other (specify below)

Table with columns: FROM, TO, PLUGGING MATERIALS. Rows: 0 to 2 Top Soil, 2 to 16 Bentonite.

7 CONTRACTOR'S OR LANDOWNER'S CERTIFICATION: This water well was plugged under my jurisdiction and was completed on (mo/day/year) 3/14/2012 and this record is true to the best of my knowledge and belief. Kansas Water Well Contractor's License No. 710. This Water Well Record was completed on (mo/day/year) 3/16/12 under the business name of Below Ground Surface, Inc. by (signature) [Signature]

INSTRUCTIONS: Use typewriter or ballpoint pen. Please press firmly and print clearly. Please fill in blanks, underline or circle the correct answers. Send top three copies to Kansas Department of Health and Environment, Bureau of Water, Geology Section, 1000 SW Jackson St., Ste. 420, Topeka, Kansas 66612-1367. Telephone: 785/296-5524. Send one to Water Well Owner and retain one for your records. Visit us at http://www.kdheks.gov/waterwell/index.html.

Check one: White Copy Blue Copy Pink Copy