

WATER WELL PLUGGING RECORD Form WWC-5P KSA 82a-1212 ID NO. MW-10

1 **LOCATION OF WATER WELL:** Fraction 1/4 SE 1/4 NE 1/4 NW 1/4 Section Number 22 Township Number T 2 S Range Number 6 E W
 County: Jewel

Street/Rural Address of Well Location; if unknown, distance & direction from nearest town or intersection: If at owner's address, check here

RR Depot in Lovewell, KS

Global Positioning Systems (GPS) information:

Latitude: 39.8681 (in decimal degrees)
 Longitude: 97.9823 (in decimal degrees)
 Elevation: _____

Datum: WGS84, NAD83, NAD27


Collection Method: GPS unit (Make/Model: Garmin e-truck)

Digital Map/Photo, Topographic Map, Land Survey

Est. Accuracy: < 3 m, 3-5 m, 5-15 m, > 15 m

2 **WATER WELL OWNER:** BNSF Railway Co.
 RR#, St. Address, Box #: 4515 Kansas Ave.
 City, State ZIP Code: Kansas City KS 66106

3 **MARK WELL'S LOCATION WITH AN "X" IN SECTION BOX:**

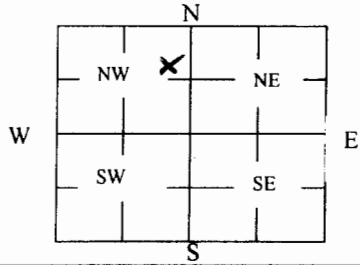

4 **DEPTH OF WELL** 16.4 ft.

WELL'S STATIC WATER LEVEL _____ ft

WELL WAS USED AS:

- Domestic
- Public Water Supply
- Dewatering
- Irrigation
- Oil Field Water Supply
- Monitoring
- Feedlot
- Domestic (Lawn & Garden)
- Injection Well
- Industrial
- Air Conditioning
- Other _____

Was a chemical/bacteriological sample submitted to Department? Yes No

5 **TYPE OF BLANK CASING USED:**

- Steel
- RMP (SR)
- Wrought
- Fiberglass
- Other (Specify below) _____
- PVC
- ABS
- Asbestos-Cement
- Concrete Tile

Blank casing diameter 2 in. Was casing pulled? Yes No If yes, how much All
 Casing height above or below land surface 29 in.

6 **GROUT PLUG MATERIAL:** Neat cement Cement grout Bentonite Other _____

Grout Plug Intervals: From 16.4 ft. to 2 ft., From _____ ft. to _____ ft., From _____ to _____ ft.

What is the nearest source of possible contamination:

- Septic tank
- Seepage pit
- Fuel Storage
- Other (specify below) _____
- Sewer lines
- Pit privy
- Fertilizer storage
- Watertight sewer lines
- Sewage lagoon
- Insecticide storage
- Lateral lines
- Feedyard
- Abandoned water well
- Direction from well? _____
- Cess pool
- Livestock pens
- Oil well/Gas well
- How many feet? _____

FROM	TO	PLUGGING MATERIALS	FROM	TO	PLUGGING MATERIALS
0	2	Top Soil			
2	16.4	Bentonite			

7 **CONTRACTOR'S OR LANDOWNER'S CERTIFICATION:** This water well was plugged under my jurisdiction and was completed on (mo/day/year) 3/14/2012 and this record is true to the best of my knowledge and belief. Kansas Water Well Contractor's License No. 710. This Water Well Record was completed on (mo/day/year) 3/16/12 under the business name of Below Ground Surface, Lnc. by (signature) [Signature]

INSTRUCTIONS: Use typewriter or ballpoint pen. Please press firmly and print clearly. Please fill in blanks, underline or circle the correct answers. Send top three copies to Kansas Department of Health and Environment, Bureau of Water, Geology Section, 1000 SW Jackson St., Ste. 420, Topeka, Kansas 66612-1367. Telephone: 785/296-5524. Send one to Water Well Owner and retain one for your records. Visit us at <http://www.kdheks.gov/waterwell/index.html>.

Check one: White Copy Blue Copy Pink Copy