


1 LOCATION OF WATER WELL: Fraction SE 1/4 SE 1/4 SE 1/4 Section Number 9 Township Number T 30 S Range Number R 1 E  
 County: Sumner Distance and direction from nearest town or city street address of well if located within city?

3 W. 2 So. Peck Kansas

2 WATER WELL OWNER: Don Nickelson Board of Agriculture, Division of Water Resources  
 RR#, St. Address, Box #: 2 Peck KS 67120 Application Number:

3 LOCATE WELL'S LOCATION WITH AN "X" IN SECTION BOX:

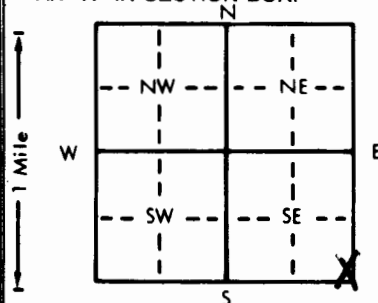

4 DEPTH OF COMPLETED WELL: 50 ft. ELEVATION: 30 ft. below land surface measured on 9/8/81

Depth(s) Groundwater Encountered 1. 30 ft. 2. 32 ft. 3. 12-15 ft.

WELL'S STATIC WATER LEVEL 30 ft. below land surface measured on 9/8/81

Pump test data: Well water was 32 ft. after 1/2 hours pumping 12-15 gpm

Est. Yield 12-15 gpm Well water was 32 ft. after 1/2 hours pumping 12-15 gpm

Bore Hole Diameter 1 1/2 in. to 50 ft. and 50 in. to 50 ft.

WELL WATER TO BE USED AS: 5 Public water supply 8 Air conditioning 11 Injection well  
 1 Domestic 3 Feedlot 6 Oil field water supply 9 Dewatering 12 Other (Specify below)

2 Irrigation 4 Industrial 7 Lawn and garden only 10 Observation well  
 Was a chemical/bacteriological sample submitted to Department? Yes X No X If yes, mo/day/yr sample was submitted

Water Well Disinfected? Yes X No X

5 TYPE OF BLANK CASING USED: 5 Wrought iron 8 Concrete tile CASING JOINTS: Glued X Clamped X

1 Steel 3 RMP (SR) 6 Asbestos-Cement 9 Other (specify below) Welded X

2 PVC 4 ABS 7 Fiberglass Threaded X

Blank casing diameter 5 in. to 30 ft. Dia. 5 in. to 30 ft. Dia. 5 in. to 30 ft. Dia. 5 in. to 30 ft.

Casing height above land surface 12 in. weight 1.59 lbs./ft. Wall thickness or gauge No SOR-26

TYPE OF SCREEN OR PERFORATION MATERIAL: 7 PVC 10 Asbestos-cement

1 Steel 3 Stainless steel 5 Fiberglass 8 RMP (SR) 11 Other (specify)

2 Brass 4 Galvanized steel 6 Concrete tile 9 ABS 12 None used (open hole)

SCREEN OR PERFORATION OPENINGS ARE: 5 Gauzed wrapped 8 Saw cut 11 None (open hole)

1 Continuous slot 3 Mill slot 6 Wire wrapped 9 Drilled holes

2 Louvered shutter 4 Key punched 7 Torch cut 10 Other (specify)

SCREEN-PERFORATED INTERVALS: From 30 ft. to 50 ft. From 30 ft. to 50 ft.

GRAVEL PACK INTERVALS: From 13 ft. to 50 ft. From 13 ft. to 50 ft.

6 GROUT MATERIAL: 1 Neat cement 2 Cement grout 3 Bentonite 4 Other

Grout Intervals: From 3 ft. to 13 ft. From 3 ft. to 13 ft.

What is the nearest source of possible contamination: 10 Livestock pens 14 Abandoned water well

1 Septic tank 4 Lateral lines 7 Pit privy 11 Fuel storage 15 Oil well/Gas well

2 Sewer lines 5 Cess pool 8 Sewage lagoon 12 Fertilizer storage 16 Other (specify below)

3 Watertight sewer lines 6 Seepage pit 9 Feedyard 13 Insecticide storage

Direction from well? SW How many feet? 100

FROM TO LITHOLOGIC LOG FROM TO LITHOLOGIC LOG

0 2 Top soil

2 12 red clay

12 28 green shale

28 30 Void

30 36 White chip rock

36 40 Green shale

40 50 Blue-green shale

7 CONTRACTOR'S OR LANDOWNER'S CERTIFICATION: This water well was (1) constructed, (2) reconstructed, or (3) plugged under my jurisdiction and was

completed on (mo/day/year) 9-8-81 and this record is true to the best of my knowledge and belief. Kansas

Water Well Contractor's License No. 318-81 This Water Well Record was completed on (mo/day/yr) 9/8/81

under the business name of Weninger Bulley by (signature) Weninger Bulley

INSTRUCTIONS: Use typewriter or ball point pen. PLEASE PRESS FIRMLY and PRINT clearly. Please fill in blanks, underline or circle the correct answers. Send top

three copies to Kansas Department of Health and Environment, Division of Environment, Environmental Geology Section, Topeka, KS 66620. Send one to WATER WELL

OWNER and retain one for your records.

OFFICE USE ONLY

T 30

R 1

EW

SEC. 9

SE 1/4 SE 1/4 SE 1/4