USE TYPEWRITER OR BALL POINT PEN-PRESS FIRMLY, PRINT CLEARLY.

WATER WELL RECORD
KSA 82a-1201-1215

Kansas Department of Health and Environment-Division of Environment
(Water well Contractors)
Topeka, Kansas 66620

1. Location of well:	County	Fraction	Section number	Township number	Range number
	Sumner	1/4 NE 1/4 NE 1/4	1	T 30 S	R 1W E/W

2. Distance and direction from nearest town or city:
Street address of well location if in city: 12072 Estate Lane
Peck, Kansas

3. Owner of well: Jerry Crow Construction
R.R. or street: Rt. #1
City, state, zip code: Rose Hill, Kansas

4. Locate with "X" in section below:

Sketch map:

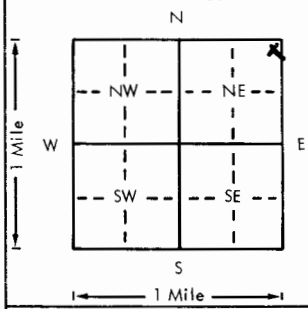

6. Bore hole dia. 11 in. Completion date 11-21-78
Well depth 45 ft.

7. __ Cable tool X Rotary __ Driven __ Dug
__ Hollow rod __ Jetted __ Bored __ Reverse rotary

8. Use: X Domestic __ Public supply __ Industry
__ Irrigation __ Air conditioning __ Stock
__ Lawn __ Oil field water __ Other

9. Casing: Material Styrene Height: Above or below ///
Threaded ___ Welded gl Surface 12 in.
RMP X PVC ___ Weight ___ lbs./ft.
Dia. 5 in. to 45 ft. depth Wall Thickness: inches or
Dia. ___ in. to ___ ft. depth gage No. .200

5. Type and color of material	From	To
Topsoil	0	3
Clay	3	12
Fine sand	12	30
Medium sand	30	45

(Use a second sheet if needed)

10. Screen: Manufacturer's name Sunflower plastic
Type styrene Dia. 5"
Slot/gauze /// .06 Length 15'
Set between 30 ft. and 45 ft.
___ ft. and ___ ft.
Gravel pack? yes Size range of material ¼-1/8"

11. Static water level: mo./day/yr.
15 ft. below land surface Date 11-21-78

12. Pumping level below land surfaces:
___ ft. after ___ hrs. pumping ___ g.p.m.
___ ft. after ___ hrs. pumping ___ g.p.m.
Estimated maximum yield ___ g.p.m.

13. Water sample submitted: mo./day/yr.
___ Yes ___ No Date ___

14. Well head completion:
X Pitless adapter 12 Inches above grade

15. Well grouted? yes 1-2fine sand mix
With: ___ Neat cement ___ Bentonite X Concrete
Depth: From 40" ft. to 14 ft.

16. Nearest source of possible contamination:
ft. 55 Direction East Type Septic
Well disinfected upon completion? X Yes tank No

17. Pump: ___ Not installed
Manufacturer's name Jacuzzi
Model number 5S4B HP ½ Volts 230
Length of drop pipe 30 ft. capacity 18 g.p.m.
Type:
X Submersible ___ Turbine
___ Jet ___ Reciprocating
___ Centrifugal ___ Other

18. Elevation:
Topography:
___ Hill
___ Slope
___ Upland
___ Valley

19. Remarks:
Flat ground

20. Water well contractor's certification:
This well was drilled under my jurisdiction and this report is true to the best of my knowledge and belief.
Harp Well & Pump 236
Business name License No.
Address Wichita, Kansas 67209
Signed M. Arnold Date 12-5-78
Authorized representative

T 30 R 1 (W) E Sec 1 1/4 1/4 1/4 ne ne

Forward the white, blue and pink copies to the Department of Health and Environment

Form WWC-5

MI-1023