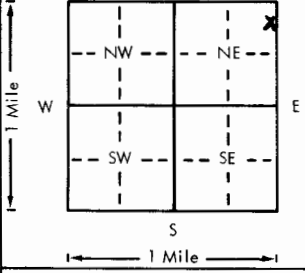


USE TYPEWRITER OR BALL
POINT PEN-PRESS FIRMLY,
PRINT CLEARLY.

WATER WELL RECORD
KSA 82a-1201-1215

Kansas Department of Health and
Environment-Division of Environment
(Water well Contractors)
Topeka, Kansas 66620

1. Location of well:		County Sumner	Fraction 1/4 NE 1/4 NE 1/4	Section number 11	Township number T 30 S R 1W E/W	Range number
2. Distance and direction from nearest town or city: Street address of well location if in city: 12109 South Meridian Peck, Kansas				3. Owner of well: Peter Pankratz Construction R.R. or street: 327 Wind Rows Lake Drive City, state, zip code: Goddard, Kansas 67052		
4. Locate with "X" in section below: 				Sketch map:		
5. Type and color of material				From	To	6. Bore hole dia. 11 in. Completion date 4-3-78 Well depth 40 ft.
Topsoil				0	2	7. <input checked="" type="checkbox"/> Cable tool <input checked="" type="checkbox"/> Rotary <input type="checkbox"/> Driven <input type="checkbox"/> Dug <input type="checkbox"/> Hollow rod <input type="checkbox"/> Jetted <input type="checkbox"/> Bored <input type="checkbox"/> Reverse rotary
Sandy Soil				2	8	8. Use: <input checked="" type="checkbox"/> Domestic <input type="checkbox"/> Public supply <input type="checkbox"/> Industry <input type="checkbox"/> Irrigation <input type="checkbox"/> Air conditioning <input type="checkbox"/> Stock <input type="checkbox"/> Lawn <input type="checkbox"/> Oil field water <input type="checkbox"/> Other
Fine Sand				8	15	9. Casing: Material styrene Height: Above or below 111 Threaded <input type="checkbox"/> Welded <input checked="" type="checkbox"/> Surface 12 in. RMP <input checked="" type="checkbox"/> PVC <input type="checkbox"/> Weight 40 lbs./ft. Dia. 5 in. to 40 ft. depth Wall Thickness: inches or 1/2 Dia. 5 in. to 40 ft. depth gage No. 200
Medium Sand				15	29	10. Screen: Manufacturer's name Sunflower Plastic Type styrene Dia. 5" Slot 1/16 in. .06 Length 10' Set between 30 ft. and 40 ft. Gravel pack? yes range of material 1/2-1/8"
Coarse Sand				29	40	11. Static water level: 15 ft. below land surface Date 4-3-78 mg./day/yr.
						12. Pumping level below land surfaces: ____ ft. after ____ hrs. pumping ____ g.p.m. ____ ft. after ____ hrs. pumping ____ g.p.m. Estimated maximum yield ____ g.p.m.
						13. Water sample submitted: ____ mo./day/yr. Yes ____ No ____ Date ____
						14. Well head completion: <input checked="" type="checkbox"/> Pitless adapter 12 inches above grade
						15. Well grouted? yes 1-2 fine sand mix With: <input checked="" type="checkbox"/> Neat cement <input type="checkbox"/> Bentonite <input checked="" type="checkbox"/> Concrete Depth: From 40' ft. to 14 ft.
						16. Nearest source of possible contamination: NONE ft. ____ Direction ____ Type ____ Well disinfected upon completion? <input checked="" type="checkbox"/> Yes ____ No ____
						17. Pump: Pioneer Pump Not installed Manufacturer's name A18 HP 3/4 Volts 230 Model number 30 ft. capacity 18 g.p.m. Length of drop pipe 30 ft. capacity 18 g.p.m. Type: <input checked="" type="checkbox"/> Submersible <input type="checkbox"/> Turbine <input type="checkbox"/> Jet <input type="checkbox"/> Reciprocating <input type="checkbox"/> Centrifugal <input type="checkbox"/> Other
						(Use a second sheet if needed)
18. Elevation:		19. Remarks: Flat Ground		20. Water well contractor's certification: This well was drilled under my jurisdiction and this report is true to the best of my knowledge and belief. Harp Well & Pump Serv. 236 Business name Wichita, Kansas sense No. Address M. Arnold Signed M. Arnold Date 5-2-78 Authorized representative		
Topography: ____ Hill ____ Slope ____ Upland ____ Valley		Septic system not installed at this time. No apparent source for contamination.				

Forward the white, blue and pink copies to the Department of Health and Environment

Form WWC-5