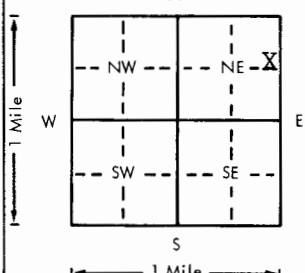


USE TYPEWRITER OR BALL
POINT PEN-PRESS FIRMLY,
PRINT CLEARLY.

WATER WELL RECORD
KSA 82a-1201-1215

Kansas Department of Health and
Environment-Division of Environment
(Water well Contractors)
Topeka, Kansas 66620

1. Location of well:		County SUMNER	Section SE 1/4 NE 1/4	Section number 12	Township number T 30 S	Range number R 1W
2. Distance and direction from nearest town or city: 1 1/4 mi. S. of Peck, Ks., on Meridian, on W. side of rd.		3. Owner of well: John Wharton R.R. or street: 823 No. Sumner City, state, zip code: Belle Plaine, Kansas				
4. Locate with "X" in section below: 		Sketch map:		6. Bore hole dia. 11 in. Completion date 5-9-79 Well depth 55 ft.		
5. Type and color of material		From		To		7. <input checked="" type="checkbox"/> Cable tool <input checked="" type="checkbox"/> Rotary <input type="checkbox"/> Driven <input type="checkbox"/> Dug <input type="checkbox"/> Hollow rod <input type="checkbox"/> Jetted <input type="checkbox"/> Bored <input type="checkbox"/> Reverse rotary
		0		2		8. Use: <input checked="" type="checkbox"/> Domestic <input type="checkbox"/> Public supply <input type="checkbox"/> Industry <input type="checkbox"/> Irrigation <input type="checkbox"/> Air conditioning <input type="checkbox"/> Stock <input type="checkbox"/> Lawn <input type="checkbox"/> Oil field water <input type="checkbox"/> Other
		2		16		9. Casing: Material Styrene Height: Above or below 12 1/4 Threaded <input type="checkbox"/> Welded <input type="checkbox"/> Surface <input type="checkbox"/> in. RMP <input checked="" type="checkbox"/> PVC <input type="checkbox"/> Weight <input type="checkbox"/> lbs./ft.
		16		30		Dia. 5 in. to 55 ft. depth Wall Thickness: inches or Dia. <input type="checkbox"/> in. to <input type="checkbox"/> ft. depth gage No. .200
		30		50		10. Screen: Manufacturer's name Sunflower Plastic Type Styrene Dia. 5" Slot 3/16 Length 20' Set between 35 ft. and 55 ft. Gravel pack? yes Size range of material 1-1/8"
Coarse Sand		30		50		11. Static water level: 20 ft. below land surface Date 5-9-79
Blue Shale		50		55		12. Pumping level below land surfaces: ____ ft. after ____ hrs. pumping ____ g.p.m. ____ ft. after ____ hrs. pumping ____ g.p.m. Estimated maximum yield ____ g.p.m.
						13. Water sample submitted: ____ mo./day/yr. ____ Yes ____ No Date ____
						14. Well head completion: capped ____ Pitless adapter 12 inches above grade
						15. Well grouted? yes 1-2 Fine Sand Mix With: ____ Neat cement ____ Bentonite <input checked="" type="checkbox"/> Concrete Depth: From 40" ft. to 14' ft.
						16. Nearest source of possible contamination: Septic Tank ft. 75 Direction S.W. Type Tank Well disinfected upon completion? <input checked="" type="checkbox"/> Yes ____ No
						17. Pump: <input checked="" type="checkbox"/> Not installed Manufacturer's name ____ Model number ____ HP ____ Volts ____ Length of drop pipe ____ ft. capacity ____ g.p.m. Type: ____ Submersible ____ Turbine ____ Jet ____ Reciprocating ____ Centrifugal ____ Other
18. Elevation:		19. Remarks:		20. Water well contractor's certification: This well was drilled under my jurisdiction and this report is true to the best of my knowledge and belief. Harp Well & Pump 236 Business name Wichita, Kansas License No. 67209 Address Wichita, Kansas Signed Dr. Arnold Date 5-6-79 Authorized representative		

Forward the white, blue and pink copies to the Department of Health and Environment

Form WWC-5