

1 LOCATION OF WATER WELL: Fraction NE 1/4 SE 1/4 NW 1/4 Section Number 16 Township Number T 30 S Range Number R 10 W
 County Logan

Distance and direction from nearest town or city street address of well if located within city?

2 WATER WELL OWNER: St. John Lutheran Church Craig Street


RR#, St. Address, Box #

City, State, ZIP Code Nashville, Kansas

Board of Agriculture, Division of Water Resources

Application Number:

3 LOCATE WELL'S LOCATION WITH AN "X" IN SECTION BOX:

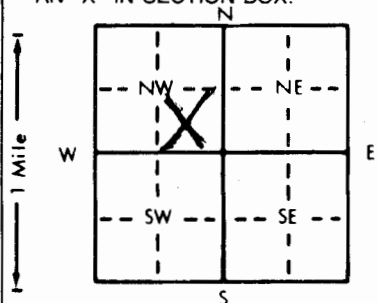

4 DEPTH OF COMPLETED WELL 60 ft. ELEVATION:

Depth(s) Groundwater Encountered 1. 26 ft. 2. 8-16 ft. 3. 96 ft.

WELL'S STATIC WATER LEVEL 26 ft. below land surface measured on mo/day/yr 8-16-96



Bore Hole Diameter 12 in. to 60 ft., and 60 in. to 96 ft.

WELL WATER TO BE USED AS: 5 Public water supply 8 Air conditioning 11 Injection well

① Domestic 3 Feedlot 6 Oil field water supply 9 Dewatering 12 Other (Specify below)

2 Irrigation 4 Industrial 7 Lawn and garden only 10 Monitoring well

Was a chemical/bacteriological sample submitted to Department? Yes No If yes, mo/day/yr sample was submitted

Water Well Disinfected? Yes No

5 TYPE OF BLANK CASING USED:

1 Steel 3 RMP (SR) 5 Wrought iron 8 Concrete tile CASING JOINTS: Glued Clamped
 ② PVC 4 ABS 6 Asbestos-Cement 9 Other (specify below) Welded
 7 Fiberglass Threaded

Blank casing diameter 5 in. to 40 ft. Dia 40 in. to 160 ft. Dia 160 in. to 14 ft.

Casing height above land surface 2 feet in., weight 160 lbs./ft. Wall thickness or gauge No. 14

TYPE OF SCREEN OR PERFORATION MATERIAL:

1 Steel 3 Stainless steel 5 Fiberglass 8 RMP (SR) 10 Asbestos-cement
 2 Brass 4 Galvanized steel 6 Concrete tile 9 ABS 11 Other (specify)
 12 None used (open hole)

SCREEN OR PERFORATION OPENINGS ARE:

① Continuous slot ③ Mill slot 5 Gauzed wrapped 8 Saw cut 11 None (open hole)
 2 Louvered shutter 4 Key punched 6 Wire wrapped 9 Drilled holes
 7 Torch cut 10 Other (specify)

SCREEN-PERFORATED INTERVALS: From 40 ft. to 60 ft. From 60 ft. to 96 ft.

From 60 ft. to 96 ft. From 96 ft. to 14 ft.

GRAVEL PACK INTERVALS: From 30 ft. to 60 ft. From 60 ft. to 96 ft.

From 96 ft. to 14 ft.

6 GROUT MATERIAL: 1 Neat cement ② Cement grout 3 Bentonite 4 Other


What is the nearest source of possible contamination:

1 Septic tank 4 Lateral lines 7 Pit privy 10 Livestock pens 14 Abandoned water well
 2 Sewer lines 5 Cess pool 8 Sewage lagoon 11 Fuel storage 15 Oil well/Gas well
 ③ Watertight sewer lines 6 Seepage pit 9 Feedyard 12 Fertilizer storage 16 Other (specify below)
 13 Insecticide storage

Direction from well? South

How many feet? 20

FROM TO LITHOLOGIC LOG FROM TO PLUGGING INTERVALS

0 1 Top Soil

1 10 Sand Clay

10 20 Sand fine

20 40 Sand

40 50 Sand coarse gravel

60 Coarse gravel




















7 CONTRACTOR'S OR LANDOWNER'S CERTIFICATION: This water well was ① constructed, (2) reconstructed, or (3) plugged under my jurisdiction and was completed on (mo/day/year) 8-16-96 and this record is true to the best of my knowledge and belief. Kansas

Water Well Contractor's License No. 2216 This Water Well Record was completed on (mo/day/yr) 8-16-96

under the business name of Water Well Service by (signature) Ken A. Weber