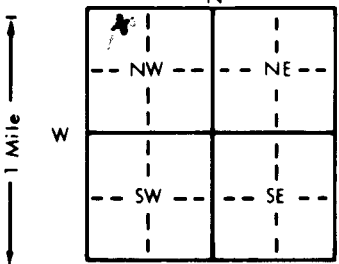


1 LOCATION OF WATER WELL: County: <b>xx Kingman</b> Fraction <b>NW 1/4 NE 1/4 NW 1/4</b> Section Number <b>16</b> Township Number <b>T 30 S</b> Range Number <b>R 10 W E/W</b>
---

Distance and direction from nearest town or city street address of well if located within city?

**In the town of Nashville**

2 WATER WELL OWNER: <b>Senior Center</b> RR#, St. Address, Box #: <b>Nashville, Ks. 67112</b> City, State, ZIP Code: _____	Board of Agriculture, Division of Water Resources Application Number: _____
--	--

3 LOCATE WELL'S LOCATION WITH AN "X" IN SECTION BOX: 	4 DEPTH OF COMPLETED WELL: <b>62</b> ft. ELEVATION: _____ Depth(s) Groundwater Encountered 1. <b>25</b> ft. 2. <b>33</b> ft. 3. _____ ft. WELL'S STATIC WATER LEVEL <b>25</b> ft. below land surface measured on mo/day/yr <b>11-20-97</b> Pump test data: Well water was _____ ft. after _____ hours pumping _____ gpm Est. Yield <b>15</b> gpm: Well water was _____ ft. after _____ hours pumping _____ gpm Bore Hole Diameter <b>5</b> in. to <b>55</b> ft. and _____ in. to _____ ft. WELL WATER TO BE USED AS: 5 Public water supply 8 Air conditioning 11 Injection well 1 Domestic 3 Feedlot 6 Oil field water supply 9 Dewatering 12 Other (Specify below) 2 Irrigation 4 Industrial 7 Lawn and garden only 10 Monitoring well Was a chemical/bacteriological sample submitted to Department? Yes <b>No</b> ; If yes, mo/day/yr sample was submitted _____ Water Well Disinfected? Yes <b>No</b>
--	--

5 TYPE OF BLANK CASING USED: 1 Steel 3 RMP (SR) 5 Wrought iron 8 Concrete tile 2 PVC 4 ABS 6 Asbestos-Cement 9 Other (specify below) 7 Fiberglass Blank casing diameter _____ in. to _____ ft., Dia _____ in. to _____ ft., Dia _____ in. to _____ ft. Casing height above land surface <b>16</b> in., weight _____ lbs./ft. Wall thickness or gauge No. <b>.210</b> TYPE OF SCREEN OR PERFORATION MATERIAL: 1 Steel 3 Stainless steel 5 Fiberglass 7 PVC 10 Asbestos-cement 2 Brass 4 Galvanized steel 6 Concrete tile 8 RMP (SR) 11 Other (specify) 9 ABS 12 None used (open hole) SCREEN OR PERFORATION OPENINGS ARE: 1 Continuous slot 3 Mill slot 5 Gauzed wrapped 8 Saw cut 11 None (open hole) 2 Louvered shutter 4 Key punched 6 Wire wrapped 9 Drilled holes 7 Torch cut 10 Other (specify) SCREEN-PERFORATED INTERVALS: From <b>55</b> ft. to _____ ft., From _____ ft. to _____ ft. From _____ ft. to _____ ft., From _____ ft. to _____ ft. GRAVEL PACK INTERVALS: From <b>3</b> ft. to <b>23</b> ft., From _____ ft. to _____ ft. From _____ ft. to _____ ft., From _____ ft. to _____ ft.
--

6 GROUT MATERIAL: 1 Neat cement 2 Cement grout 3 Bentonite 4 Other _____ Grout Intervals: From _____ ft. to _____ ft., From _____ ft. to _____ ft., From _____ ft. to _____ ft. What is the nearest source of possible contamination: 1 Septic tank 4 Lateral lines 7 Pit privy 10 Livestock pens 14 Abandoned water well 2 Sewer lines 5 Cess pool 8 Sewage lagoon 11 Fuel storage 15 Oil well/Gas well 3 Watertight sewer lines 6 Seepage pit 9 Feedyard 12 Fertilizer storage 16 Other (specify below) 13 Insecticide storage Direction from well? <b>S</b> How many feet? <b>50</b>
--

FROM	TO	LITHOLOGIC LOG	FROM	TO	PLUGGING INTERVALS
<b>0</b>	<b>2</b>	<b>soil</b>			
<b>2</b>	<b>15</b>	<b>white clay</b>			
<b>15</b>	<b>19</b>	<b>sand &amp; clay</b>			
<b>19</b>	<b>25</b>	<b>fine sand</b>			
<b>25</b>	<b>35</b>	<b>sand</b>			
<b>35</b>	<b>36</b>	<b>medium sand</b>			
<b>36</b>	<b>50</b>	<b>fine sand</b>			
<b>50</b>	<b>62</b>	<b>clean sand</b>			

7 CONTRACTOR'S OR LANDOWNER'S CERTIFICATION: This water well was (1) <del>constructed</del> (2) reconstructed, or (3) plugged under my jurisdiction and was completed on (mo/day/year) <b>11-20-97</b> and this record is true to the best of my knowledge and belief. Kansas Water Well Contractor's License No. <b>140</b> This Water Well Record was completed on (mo/day/yr) <b>11-20-97</b> under the business name of <b>Lyman Inc.</b> by (signature) <i>Lyman Inc.</i>
--