

1 LOCATION OF WATER WELL:	Fraction	Section Number	Township Number	Range Number
County: <u>Kingman</u>	<u>W 1/2 1/4 SE 1/4 1/4 SW 1/4 1/4</u>	<u>9</u>	T <u>30</u> South	R <u>10</u> W <u>N</u>


Distance and direction from nearest town or city/street address of well if located within city?

Nashville, Kansas

2 WATER WELL OWNER:	Board of Agriculture, Division of Water Resources
RR#, St. Address, Box #	Application Number:
City, State, ZIP Code	

Bob Hauser67112 Nashville, Kansas

3 LOCATE WELL'S LOCATION WITH AN "X" IN SECTION BOX:	4 DEPTH OF COMPLETED WELL: <u>60</u> ft. ELEVATION:
--	---

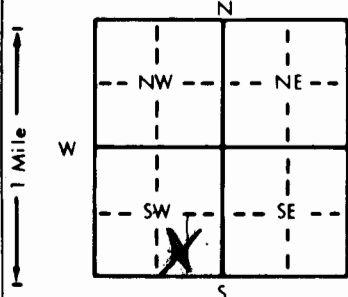

Depth(s) Groundwater Encountered 1. ft. 2. ft. 3. ft.

WELL'S STATIC WATER LEVEL 30 ft. below land surface measured on mo/day/yr 10 20 90

Pump test data: Well water was ft. after hours pumping gpm

Est. Yield 12 gpm: Well water was ft. after hours pumping gpm

Bore Hole Diameter 12 in. to 60 ft., and in. to ft.

WELL WATER TO BE USED AS:

5 Public water supply 8 Air conditioning 11 Injection well

1 Domestic 3 Feedlot 6 Oil field water supply 9 Dewatering 12 Other (Specify below)

2 Irrigation 4 Industrial 7 Lawn and garden only 10 Monitoring well

Was a chemical/bacteriological sample submitted to Department? Yes No ☒ If yes, mo/day/yr sample was submitted

Water Well Disinfected? Yes ☒ No

5 TYPE OF CASING USED:	5 Wrought iron	8 Concrete tile	CASING JOINTS: Glued Clamped
------------------------	----------------	-----------------	--

1 Steel 3 RMP (SR) 6 Asbestos-Cement 9 Other (specify below) Welded

2 PVC 4 ABS 7 Fiberglass Threaded

Blank casing diameter 5 in. to 40 ft., Dia. in. to ft., Dia. in. to ft.

Casing height above land surface 2 feet in., weight lbs./ft. Wall thickness or gauge No. 14

TYPE OF SCREEN OR PERFORATION MATERIAL:	7 PVC	10 Asbestos-cement
---	-------	--------------------

1 Steel 3 Stainless steel 5 Fiberglass 8 RMP (SR) 11 Other (specify)

2 Brass 4 Galvanized steel 6 Concrete tile 9 ABS 12 None used (open hole)

SCREEN OR PERFORATION OPENINGS ARE:	5 Gauzed wrapped	8 Saw cut	11 None (open hole)
-------------------------------------	------------------	-----------	---------------------

1 Continuous slot 3 Mill slot 6 Wire wrapped 9 Drilled holes

2 Louvered shutter 4 Key punched 7 Torch cut 10 Other (specify)

SCREEN-PERFORATED INTERVALS:	From <u>40</u> ft. to <u>60</u> ft., From ft. to ft.
------------------------------	--

From ft. to ft., From ft. to ft.

GRAVEL PACK INTERVALS:	From <u>10</u> ft. to <u>60</u> ft., From ft. to ft.
------------------------	--

From ft. to ft., From ft. to ft.

6 GROUT MATERIAL:	1 Neat cement	2 Cement grout	3 Bentonite	4 Other
-------------------	---------------	----------------	-------------	---------------

Grout Intervals: From 9 ft. to 10 ft., From ft. to ft., From ft. to ft.

What is the nearest source of possible contamination:

1 Septic tank 4 Lateral lines 7 Pit privy 10 Livestock pens 14 Abandoned water well

2 Sewer lines 5 Cess pool 8 Sewage lagoon 11 Fuel storage 15 Oil well/Gas well

3 Watertight sewer lines 6 Seepage pit 9 Feedyard 12 Fertilizer storage 16 Other (specify below)

13 Insecticide storage NONE

Direction from well? How many feet?

FROM	TO	LITHOLOGIC LOG	FROM	TO	PLUGGING INTERVALS
------	----	----------------	------	----	--------------------

0	1	Top Soil			
1	10	Gravel & Clay			
10	20	Clay			
20	30	Soft fine			
30	40	Clay Soft			
40	50	Soft coarse			
60		Coarse gravel			
		Total Depth of well 60 feet			
		Clay Bottom			

7 CONTRACTOR'S OR LANDOWNER'S CERTIFICATION: This water well was (1) constructed, (2) reconstructed, or (3) plugged under my jurisdiction and was completed on (mo/day/year) <u>6 20 90</u> and this record is true to the best of my knowledge and belief. Kansas
--

Water Well Contractor's License No. 226 This Water Well Record was completed on (mo/day/yr) 6 20 90

under the business name of Weber Well Service by (signature) Dean A. Weber