

USE TYPEWRITER OR BALL POINT PEN-PRESS FIRMLY, PRINT CLEARLY.


T R EW sec 1/4 1/4 1/4 No.

WATER WELL RECORD
KSA 82a-1201-1215

Kansas State Dept. Of Health
(Water Well Contractors)
Forbes-Bldg. 740
Topeka, Kansas 66620

1 Location of well: County KINGMAN Township name LIBERTY Fraction NE 1/4 8 E 1/4 Section number 10 Town number 30 Range number 10

Distance and direction from nearest town or city: 1/2 MILE EAST 1 MILE NORTH 1 MILE EAST
Street address of well location if in city: NASHVILLE Kansas
3 Owner of well: VERNA KATZER
Address: 1053 - COOLIDGE WICHITA KANSAS 67203

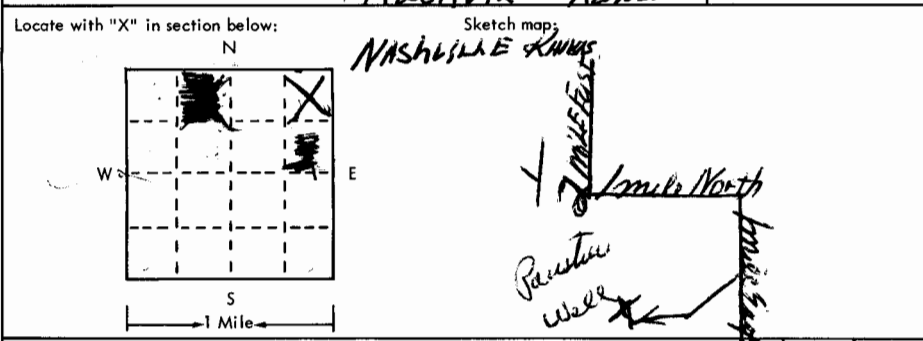

4 Well depth: 45 ft. Date of completion _____
Well diameter 8 in.

5 Cable tool Rotary Driven Dug
 Hollow rod Jetted Bored Reverse rotary

6 Use: Domestic Public supply Industry
 Irrigation Air conditioning Commercial
 Test well STOCK WELL

7 Casing: Material Pvc Height: above/below
Threaded Welded Surface 24 in.
Diam. 5 in. to 45 ft. depth! Drive shoe? Yes No
_____ in. to _____ ft. depth!

2	Type and color of material	From	To
	<u>SOIL</u>	<u>0</u>	<u>1</u>
	<u>Sand and clay</u>	<u>1</u>	<u>30</u>
	<u>Clay</u>	<u>30</u>	<u>35</u>
	<u>course gravel</u>	<u>40</u>	<u>45</u>
	<u>TOTAL DEPTH 45 feet</u>		
	<u>Clay Bottom</u>		

8 Screen: Manufacturer JESS T LOWELL
Type Pvc Dia. 5"
Slot/gauze 5/16 Length 10 feet
Set between 35 ft. and 45 ft. course gravel.
Fittings: Gravel pack Yes No Size range of material 4

9 Static water level: 30 ft. below land surface Date 3-25-75

10 Pumping level below land surfaces: NH
_____ ft. after _____ hrs. pumping _____ g.p.m.
_____ ft. after _____ hrs. pumping _____ g.p.m.
Estimated maximum yield _____ g.p.m.

11 Water sample submitted: Yes No Date 3-25-75

12 Well head completion: 2 Tel 2" Packer unit
 Pitless adapter 2 feet Inches above grade

13 Well grouted? Yes No
 Neat cement Bentonite _____
Depth: From 1 ft. to 10 ft.

14 Nearest source of possible contamination: NONE Packer
ft. _____ Direction _____ Type _____
Well disinfected upon completion? Yes No

15 Pump: 6 foot AEO motor mill Not installed
Manufacturer's name _____ Type _____
Model number _____ HP _____ Volts _____
Length of drop pipe 35 ft. capacity _____ g.m.p.
Type: Submersible Turbine
 Jet Reciprocating
 Centrifugal Other

16 Remarks: elevation _____

Topography:
 Hill
 Slope
 Upland
 Valley

17 Water well contractor's certification:
This well was drilled under my jurisdiction and this report is true to the best of my knowledge and belief.
WEBER WELL SERVICE 226
Business name _____ License No. _____
Address NASHVILLE KANSAS
Signed Leon Aulburn Date 3-25-75
Authorized representative