


1 LOCATION OF WATER WELL:	Fraction	Section Number	Township Number	Range Number
County: <u>Kingman</u>	<u>NE 1/4 SW 1/4 NW 1/4</u>	<u>16</u>	<u>T 305 S</u>	<u>R 10 W</u>

Distance and direction from nearest town or city street address of well if located within city?

City of Nashville Kansas

2 WATER WELL OWNER:	Board of Agriculture, Division of Water Resources
RR#, St. Address, Box #:	Application Number:
City, State, ZIP Code	

3 LOCATE WELL'S LOCATION WITH AN "X" IN SECTION BOX:	4 DEPTH OF COMPLETED WELL: <u>60</u> ft. ELEVATION:
--	---

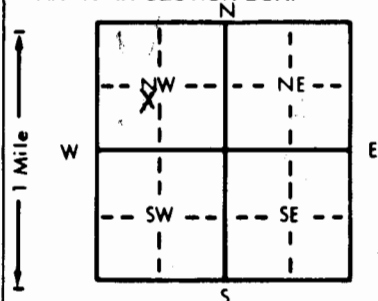

Depth(s) Groundwater Encountered	1	ft. 2.	ft. 3.	ft.
WELL'S STATIC WATER LEVEL	<u>24</u>	ft. below land surface measured on mo/day/yr	<u>3-10</u>	<u>8.8</u>
Pump test data: Well water was	<u>NA</u>	ft. after	hours pumping	gpm
Est. Yield	<u>15</u>	gpm: Well water was	ft. after	hours pumping
Bore Hole Diameter	<u>12</u>	in. to	<u>60</u>	ft., and
WELL WATER TO BE USED AS:	5 Public water supply	8 Air conditioning	11 Injection well	
	① Domestic	3 Feedlot	6 Oil field water supply	9 Dewatering
	2 Irrigation	4 Industrial	7 Lawn and garden only	10 Observation well
Was a chemical/bacteriological sample submitted to Department?	Yes	No	If yes, mo/day/yr sample was submitted	
Water Well Disinfected?	Yes	No		

5 TYPE OF BLANK CASING USED:	5 Wrought iron	8 Concrete tile	CASING JOINTS: Glued	Clamped
1 Steel	3 RMP (SR)	6 Asbestos-Cement	9 Other (specify below)	Welded
② PVC	4 ABS	7 Fiberglass		Threaded

Blank casing diameter	<u>5</u>	in. to	<u>60</u>	ft., Dia	in. to	ft., Dia	in. to	ft.
Casing height above land surface	<u>2</u>	feet	in., weight	lbs./ft.	Wall thickness or gauge No.	<u>14</u>		

TYPE OF SCREEN OR PERFORATION MATERIAL:	⑦ PVC	10 Asbestos-cement
1 Steel	3 Stainless steel	5 Fiberglass
2 Brass	4 Galvanized steel	6 Concrete tile
		8 RMP (SR)
		9 ABS
		11 Other (specify)
		12 None used (open hole)

SCREEN OR PERFORATION OPENINGS ARE:	5 Gauzed wrapped	8 Saw cut	11 None (open hole)
① Continuous slot	3 Mill slot	6 Wire wrapped	9 Drilled holes
2 Louvered shutter	4 Key punched	7 Torch cut	10 Other (specify)

SCREEN-PERFORATED INTERVALS:	From	<u>40</u>	ft. to	<u>60</u>	ft., From	ft. to	ft.
	From		ft. to		ft., From	ft. to	ft.
GRAVEL PACK INTERVALS:	From	<u>20</u>	ft. to	<u>60</u>	ft., From	ft. to	ft.
	From		ft. to		ft., From	ft. to	ft.

6 GROUT MATERIAL:	① Neat cement	2 Cement grout	3 Bentonite	4 Other
Grout Intervals:	From	<u>1</u>	ft. to	<u>20</u>

What is the nearest source of possible contamination:	10 Livestock pens	14 Abandoned water well
1 Septic tank	4 Lateral lines	7 Pit privy
② Sewer lines	5 Cess pool	8 Sewage lagoon
3 Watertight sewer lines	6 Seepage pit	9 Feedyard
		11 Fuel storage
		12 Fertilizer storage
		13 Insecticide storage
		15 Oil well/Gas well
		16 Other (specify below)

Direction from well?	<u>East</u>	How many feet?	<u>100 feet</u>
----------------------	-------------	----------------	-----------------

FROM	TO	LITHOLOGIC LOG	FROM	TO	LITHOLOGIC LOG
0	1	Top Soil			
1	10	Clay			
10	20	Sand fine			
30	40	Brown Clay			
40	50	Sand coarse			
50	60	Coarse Gravel			
		Clay Bottom			
		60 foot Total Depth			

7 CONTRACTOR'S OR LANDOWNER'S CERTIFICATION: This water well was	① constructed, (2) reconstructed, or (3) plugged under my jurisdiction and was completed on (mo/day/year)	<u>3-10-88</u>	and this record is true to the best of my knowledge and belief. Kansas
Water Well Contractor's License No.	<u>206</u>	This Water Well Record was completed on (mo/day/yr)	<u>3-10-88</u>
under the business name of	<u>Weber Well Service</u>	by (signature)	<u>Leon A. Weber</u>

INSTRUCTIONS: Use typewriter or ball point pen. PLEASE PRESS FIRMLY and PRINT clearly. Please fill in blanks. underline or circle the correct answers. Send top three copies to Kansas Department of Health and Environment, Bureau of Water Protection, Topeka, Kansas 66620-7320, Telephone: 913-862-9360. Send one to WATER WELL OWNER and retain one for your records.