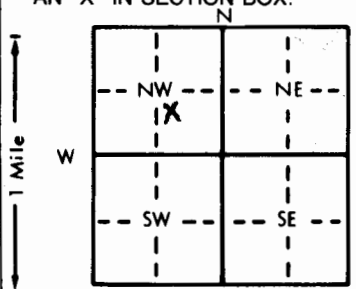


1 LOCATION OF WATER WELL: County: <u>Kingman</u>	Fraction <u>NW</u> $\frac{1}{4}$ <u>SE</u> $\frac{1}{4}$ <u>NW</u> $\frac{1}{4}$	Section Number <u>16</u>	Township Number <u>T 30 S</u>	Range Number <u>R 10 W</u>
---	--	--------------------------	-------------------------------	----------------------------

Distance and direction from nearest town or city street address of well if located within city?

2 WATER WELL OWNER: <u>Alfred Knowles</u> RR#, St. Address, Box # <u>25</u> City, State, ZIP Code <u>Nashville, KS, 67112</u>	Board of Agriculture, Division of Water Resources Application Number:
---	--

3 LOCATE WELL'S LOCATION WITH AN "X" IN SECTION BOX: 	4 DEPTH OF COMPLETED WELL: <u>60</u> ft. ELEVATION: ..... ft. Depth(s) Groundwater Encountered 1. .... ft. 2. .... ft. 3. .... ft. WELL'S STATIC WATER LEVEL <u>20</u> ft. below land surface measured on mo/day/yr <u>6-20-83</u> Pump test data: Well water was ..... ft. after ..... hours pumping ..... gpm Est. Yield <u>20</u> gpm: Well water was ..... ft. after ..... hours pumping ..... gpm Bore Hole Diameter <u>12</u> in. to <u>60</u> ft., and ..... in. to ..... ft. WELL WATER TO BE USED AS: <table border="0"> <tr> <td><input checked="" type="radio"/> Domestic</td> <td>3 Feedlot</td> <td>6 Oil field water supply</td> <td>9 Dewatering</td> <td>12 Other (Specify below)</td> </tr> <tr> <td>2 Irrigation</td> <td>4 Industrial</td> <td>7 Lawn and garden only</td> <td>10 Observation well</td> <td></td> </tr> </table>	<input checked="" type="radio"/> Domestic	3 Feedlot	6 Oil field water supply	9 Dewatering	12 Other (Specify below)	2 Irrigation	4 Industrial	7 Lawn and garden only	10 Observation well	
<input checked="" type="radio"/> Domestic	3 Feedlot	6 Oil field water supply	9 Dewatering	12 Other (Specify below)							
2 Irrigation	4 Industrial	7 Lawn and garden only	10 Observation well								

Was a chemical/bacteriological sample submitted to Department? Yes ..... No ☒; If yes, mo/day/yr sample was submitted  
Water Well Disinfected? Yes ☒ No

5 TYPE OF BLANK CASING USED: 1 Steel <input checked="" type="radio"/> 2 PVC 3 RMP (SR) 4 ABS Blank casing diameter <u>5</u> in. to ..... ft., Dia ..... in. to ..... ft. Casing height above land surface <u>2 feet</u> in., weight ..... lbs./ft. Wall thickness or gauge No. <u>14</u> TYPE OF SCREEN OR PERFORATION MATERIAL: 1 Steel 2 Brass 3 Stainless steel 4 Galvanized steel 5 Fiberglass 6 Concrete tile 7 Torch cut 8 RMP (SR) 9 ABS 10 Asbestos-cement 11 Other (specify) ..... 12 None used (open hole)	5 Wrought iron 6 Asbestos-Cement 7 Fiberglass 8 Concrete tile 9 Other (specify below) CASING JOINTS: Glued <input checked="" type="checkbox"/> Clamped ..... Welded ..... Threaded ..... 8 Saw cut 11 None (open hole) 9 Drilled holes 10 Other (specify) ..... SCREEN OR PERFORATION OPENINGS ARE: <input checked="" type="radio"/> Continuous slot 2 Louvered shutter 3 Mill slot 4 Key punched 5 Gauzed wrapped 6 Wire wrapped 7 Torch cut 8 Saw cut 11 None (open hole) 9 Drilled holes 10 Other (specify) ..... SCREEN-PERFORATED INTERVALS: From <u>50</u> ft. to <u>60</u> ft., From ..... ft. to ..... ft. From ..... ft. to ..... ft., From ..... ft. to ..... ft. GRAVEL PACK INTERVALS: From <u>10</u> ft. to <u>60</u> ft., From ..... ft. to ..... ft. From ..... ft. to ..... ft., From ..... ft. to ..... ft.
---	---

6 GROUT MATERIAL: <input checked="" type="radio"/> Neat cement 2 Cement grout 3 Bentonite 4 Other ..... Grout Intervals: From <u>1</u> ft. to <u>10</u> ft., From ..... ft. to ..... ft., From ..... ft. to ..... ft. What is the nearest source of possible contamination: 1 Septic tank 2 Sewer lines <input checked="" type="radio"/> 3 Watertight sewer lines 4 Lateral lines 5 Cess pool 6 Seepage pit 7 Pit privy 8 Sewage lagoon 9 Feedyard 10 Livestock pens 11 Fuel storage 12 Fertilizer storage 13 Insecticide storage 14 Abandoned water well 15 Oil well/Gas well 16 Other (specify below) ..... Direction from well? ..... How many feet? <u>50 feet</u>
---

FROM	TO	LITHOLOGIC LOG	FROM	TO	LITHOLOGIC LOG
Top Soil	0	Top Soil			
10	10	Red sand and clay			
20	20	Sand fine			
30	30	Clay and white silt			
40	50	Sand coarse			
50	60	Coarse gravel			
		Total Dept of Well - 60 feet			
		Clay Bottom			

7 CONTRACTOR'S OR LANDOWNER'S CERTIFICATION: This water well was <input checked="" type="radio"/> constructed, (2) reconstructed, or (3) plugged under my jurisdiction and was completed on (mo/day/year) <u>6-20-83</u> and this record is true to the best of my knowledge and belief. Kansas Water Well Contractor's License No. <u>226</u> This Water Well Record was completed on (mo/day/yr) <u>6-20-83</u> under the business name of <u>Weber Well Service</u> by (signature) <u>Leon A. Weber</u>
--

INSTRUCTIONS: Use typewriter or ball point pen, PLEASE PRESS FIRMLY and PRINT clearly. Please fill in blanks, underline or circle the correct answers. Send top three copies to Kansas Department of Health and Environment, Division of Environment, Environmental Geology Section, Topeka, KS 66620. Send one to WATER WELL OWNER and retain one for your records.