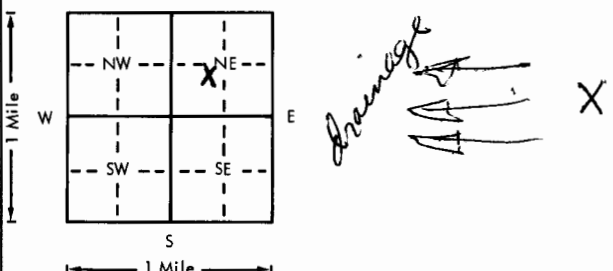


USE TYPEWRITER OR BALL
POINT PEN-PRESS FIRMLY,
PRINT CLEARLY.

WATER WELL RECORD
KSA 82a-1201-1215

Kansas Department of Health and
Environment-Division of Environment
(Water well Contractors)
Topeka, Kansas 66620

1. Location of well:		County <u>Kingman</u>	Fraction <u>NE 1/4 SW 1/4 E 1/4</u>	Section number <u>31</u>	Township number <u>T 30 S R 10 W</u>	Range number <u>E/W</u>
2. Distance and direction from nearest town or city: <u>35 1/4 W of Nashville, Ks</u>		3. Owner of well: <u>Gene Hellman</u> R.R. or street: City, state, zip code: <u>Nashville, Ks</u>		NO. 1		
4. Locate with "X" in section below: 		Sketch map:		6. Bore hole dia. <u>30</u> in. Completion date <u>16 Dec 77</u> Well depth <u>59</u> ft.		
5. Type and color of material		From	To	7. <input type="checkbox"/> Cable tool <input type="checkbox"/> Rotary <input type="checkbox"/> Driven <input type="checkbox"/> Dug <input type="checkbox"/> Hollow rod <input type="checkbox"/> Jetted <input type="checkbox"/> Bored <input checked="" type="checkbox"/> Reverse rotary		
<u>Silt, sandy</u>		0	2	8. Use: <input type="checkbox"/> Domestic <input type="checkbox"/> Public supply <input type="checkbox"/> Industry <input checked="" type="checkbox"/> Irrigation <input type="checkbox"/> Air conditioning <input type="checkbox"/> Stock <input type="checkbox"/> Lawn <input type="checkbox"/> Oil field water <input type="checkbox"/> Other		
<u>Clay, gray</u>		2	7	9. Casing: Material: <u>SRL</u> Height: <u>Above</u> or below Threaded <input type="checkbox"/> Welded <input checked="" type="checkbox"/> Surface <u>12</u> in. RMP <input type="checkbox"/> PVC <input type="checkbox"/> Weight <input type="checkbox"/> lbs./ft. Dia. <u>16</u> in. to <u>27</u> ft. depth Wall Thickness: inches or Dia. <input type="checkbox"/> in. to <input type="checkbox"/> ft. depth Gauge No. <u>188</u>		
<u>Sand, fine to coarse and med. gravel</u>		7	21	10. Screen: Manufacturer's name <u>Inflow</u> Type <u>1/8</u> Dia. <u>16"</u> Slot/gauze <u>1/8</u> Length <u>20'</u> Set between <u>27</u> ft. and <u>33</u> ft. <u>45</u> ft. and <u>59</u> ft. Gravel pack? <input checked="" type="checkbox"/> Size range of material: <u>1/4 x 1/2</u>		
<u>Sand, fine to coarse and med. to coarse gravel</u>		21	33	11. Static water level: <u>9</u> ft. below land surface Date <u>16 Dec 77</u>		
<u>Clay, tan</u>		33	45	12. Pumping level below land surfaces: <u>31</u> ft. after <u>2</u> hrs. pumping <u>300</u> g.p.m. ft. after <u> </u> hrs. pumping <u> </u> g.p.m. Estimated maximum yield <u>250</u> g.p.m.		
<u>Sand, fine to coarse and med. fine to med. gravel</u>		45	55	13. Water sample submitted: <u> </u> mo./day/yr. <input type="checkbox"/> Yes <input checked="" type="checkbox"/> No Date <u> </u>		
<u>Clay, tan</u>		55	56	14. Well head completion: <u>12</u> inches above grade <input type="checkbox"/> Pitless adapter		
<u>Sand, fine to coarse and med. to coarse gravel</u>		56	59	15. Well grouted? <input checked="" type="checkbox"/> With: <input type="checkbox"/> Neat cement <input checked="" type="checkbox"/> Bentonite <input type="checkbox"/> Concrete Depth: From <u>0</u> ft. to <u>10</u> ft.		
<u>Clay, red and tan</u>		59	64	16. Nearest source of possible contamination: ft. <u> </u> Direction <u> </u> Type <u>NONE</u> Well disinfected upon completion? <input checked="" type="checkbox"/> Yes <input type="checkbox"/> No		
<u>Shale, red</u>		64	70	17. Pump: <input checked="" type="checkbox"/> Not installed Manufacturer's name <u> </u> Model number <u> </u> HP <u> </u> Volts <u> </u> Length of drop pipe <u> </u> ft. capacity <u> </u> g.p.m. Type: <input type="checkbox"/> Submersible <input type="checkbox"/> Turbine <input type="checkbox"/> Jet <input type="checkbox"/> Reciprocating <input type="checkbox"/> Centrifugal <input type="checkbox"/> Other		
18. Elevation:		19. Remarks: <u>3' x 3' x 8" slab poured at surface</u>		20. Water well contractor's certification: This well was drilled under my jurisdiction and this report is true to the best of my knowledge and belief. <u>Central Well & Pump Svc.</u> 325 Business name License No. <u> </u> Address <u>121 S. Taylor Pratt, Ks.</u> Signed <u>Edmonial</u> Date <u>24 Dec 78</u> Authorized representative		