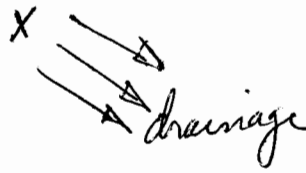


USE TYPEWRITER OR BALL
POINT PEN-PRESS FIRMLY,
PRINT CLEARLY.

WATER WELL RECORD
KSA 82a-1201-1215

Kansas Department of Health and
Environment-Division of Environment
(Water well Contractors)
Topeka, Kansas 66620

1. Location of well:		County <u>Kingman</u>	Fraction <u>SE 1/4 NW 1/4 NE 1/4</u>	Section number <u>31</u>	Township number <u>T 30</u>	Range number <u>S 10 W</u>	E/W
2. Distance and direction from nearest town or city: <u>35 + 1/4 W of Nashville</u>				3. Owner of well: <u>Dave Hellman</u> NO. 2 R.R. or street: City, state, zip code: <u>Nashville, Ks</u>			
4. Locate with "X" in section below: N W E S 1 Mile 1 Mile				Sketch map: 			
5. Type and color of material				From	To	6. Bore hole dia. <u>30</u> in. Completion date <u>20 Dec 77</u> Well depth <u>53</u> ft.	
Soil, sandy				0	2	7. <input type="checkbox"/> Cable tool <input type="checkbox"/> Rotary <input type="checkbox"/> Driven <input type="checkbox"/> Dug <input type="checkbox"/> Hollow rod <input type="checkbox"/> Jetted <input checked="" type="checkbox"/> Bored <input checked="" type="checkbox"/> Reverse rotary	
Clay, tan				2	7	8. Use: <input type="checkbox"/> Domestic <input type="checkbox"/> Public supply <input type="checkbox"/> Industry <input checked="" type="checkbox"/> Irrigation <input type="checkbox"/> Air conditioning <input type="checkbox"/> Stock <input type="checkbox"/> Lawn <input type="checkbox"/> Oil field water <input type="checkbox"/> Other	
Sand, coarse and coarse gravel				7	14	9. Casing: Material <u>STL</u> Height: <u>Above</u> or below Threaded <input type="checkbox"/> Welded <input checked="" type="checkbox"/> Surface <u>12</u> in. RMP <input type="checkbox"/> PVC <input type="checkbox"/> Weight <input type="checkbox"/> lbs./ft. Dia. <u>16</u> in. to <u>33</u> ft. depth Wall Thickness: inches or Dia. <input type="checkbox"/> in. to <input type="checkbox"/> ft. depth gage No. <u>188</u>	
Clay, tan, sandy				14	19	10. Screen: Manufacturer's name <u>Truflow</u> Type <u>16"</u> Dia. <u>16"</u> Slot/gauze <u>1/8</u> Length <u>20'</u> Set between <u>33</u> ft. and <u>53</u> ft. <u>ft.</u> and <u>ft.</u> Gravel pack? <input checked="" type="checkbox"/> Size range of material <u>1/4 X 1/2</u>	
Sand, fine to coarse and med. gravel				19	32	11. Static water level: <u>11</u> ft. below land surface Date <u>20 Dec 77</u> mo./day/yr.	
Clay, tan				32	34	12. Pumping level below land surfaces: <u>35</u> ft. after <u>1</u> hrs. pumping <u>408</u> g.p.m. <u>34</u> ft. after <u>2</u> hrs. pumping <u>609</u> g.p.m. Estimated maximum yield <u>750</u> g.p.m.	
Sand, fine to coarse and fine to coarse gravel				34	43	13. Water sample submitted: <u>mo./day/yr.</u> Yes <input checked="" type="checkbox"/> No <input type="checkbox"/> Date <u>20 Dec 77</u>	
Sand, with clay streaks				43	46	14. Well head completion: <input type="checkbox"/> Pitless adapter <u>12</u> inches above grade	
Sand, fine to coarse and fine to med. gravel				46	53	15. Well grouted? <input checked="" type="checkbox"/> With: <input checked="" type="checkbox"/> Neat cement <input checked="" type="checkbox"/> Bentonite <input type="checkbox"/> Concrete Depth: From <u>0</u> ft. to <u>10</u> ft.	
Clay, gray				53	60	16. Nearest source of possible contamination: ft. <u> </u> Direction <u> </u> Type <u>ABOVE</u> Well disinfected upon completion? <input checked="" type="checkbox"/> Yes <input type="checkbox"/> No	
						17. Pump: <input checked="" type="checkbox"/> Not installed Manufacturer's name <u> </u> Model number <u> </u> HP <u> </u> Volts <u> </u> Length of drop pipe <u> </u> ft. capacity <u> </u> g.p.m. Type: <input type="checkbox"/> Submersible <input type="checkbox"/> Turbine <input type="checkbox"/> Jet <input type="checkbox"/> Reciprocating <input type="checkbox"/> Centrifugal <input type="checkbox"/> Other	
18. Elevation:				19. Remarks: <u>5' X 10' X 8" slab poured at surface</u>			
Topography: <input type="checkbox"/> Hill <input type="checkbox"/> Slope <input checked="" type="checkbox"/> Upland <input type="checkbox"/> Valley				20. Water well contractor's certification: This well was drilled under my jurisdiction and this report is true to the best of my knowledge and belief. <u>Central Well & Pump Svc.</u> 325 Business name License No. Address <u>121 S. Taylor Pratt, Ks.</u> Signed <u>[Signature]</u> Date <u>24 Dec 77</u> Authorized representative			