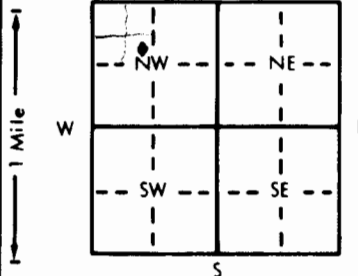


|   |    |   |                                                                          |                           |                          |
|---|----|---|--------------------------------------------------------------------------|---------------------------|--------------------------|
| 1 LOCATION OF WATER WELL:   |    | Fraction <u>SE 1/4 NW 1/4 NW 1/4</u>                                                                                   | Section Number <u>16</u>                                                 | Township Number <u>30</u> | Range Number <u>10 W</u> |
| County: <u>Kingman</u>   |    |   |                                                                          |                           |                          |
| Distance and direction from nearest town or city street address of well if located within city?<br><u>in the town of Nashville 311 Main</u>   |    |   |                                                                          |                           |                          |
| 2 WATER WELL OWNER: <u>Dan Noland</u><br>RR#, St. Address, Box # : <u>311 Main</u><br>City, State, ZIP Code : <u>Nashville, ks. 67112</u>   |    |   | Board of Agriculture, Division of Water Resources<br>Application Number: |                           |                          |
| 3 LOCATE WELL'S LOCATION WITH AN "X" IN SECTION BOX:   |    | 4 DEPTH OF COMPLETED WELL: <u>70</u> ft. ELEVATION: <u>7-27-98</u>                                                     |                                                                          |                           |                          |
|   |    | Depth(s) Groundwater Encountered 1. <u>32</u> ft. 2. <u>32</u> ft. 3. <u>32</u> ft.                                    |                                                                          |                           |                          |
|   |    | WELL'S STATIC WATER LEVEL <u>20</u> ft. below land surface measured on mo/day/yr                                       |                                                                          |                           |                          |
|   |    | Pump test data: Well water was <u>10</u> gpm: Well water was <u>10</u> ft. after <u>10</u> hours pumping <u>10</u> gpm |                                                                          |                           |                          |
|   |    | Bore Hole Diameter <u>9</u> in. to <u>70</u> ft., and <u>9</u> in. to <u>70</u> ft.                                    |                                                                          |                           |                          |
| 5 TYPE OF BLANK CASING USED:   |    | CASING JOINTS: <u>Glued</u> <u>Clamped</u> <u>Welded</u> <u>Threaded</u>                                               |                                                                          |                           |                          |
| 1 Steel 3 RMP (SR)<br>2 <u>PVC</u> 4 ABS   |    | 5 Wrought iron 8 Concrete tile<br>6 Asbestos-Cement 9 Other (specify below)                                            |                                                                          |                           |                          |
| Blank casing diameter <u>5</u> in. to <u>43</u> ft., Dia <u>17</u> in., weight <u>17</u> lbs./ft. Wall thickness or gauge No. <u>250</u>   |    | 7 Fiberglass   |                                                                          |                           |                          |
| TYPE OF SCREEN OR PERFORATION MATERIAL:   |    | 10 Asbestos-cement   |                                                                          |                           |                          |
| 1 Steel 3 Stainless steel 5 Fiberglass 8 RMP (SR)<br>2 Brass 4 Galvanized steel 6 Concrete tile 9 ABS 11 Other (specify)   |    | 12 None used (open hole)                                                                                               |                                                                          |                           |                          |
| SCREEN OR PERFORATION OPENINGS ARE:   |    | 8 Saw cut 11 None (open hole)                                                                                          |                                                                          |                           |                          |
| 1 Continuous slot 3 Mill slot 5 Gauzed wrapped 6 Wire wrapped 9 Drilled holes<br>2 Louvered shutter 4 Key punched 7 Torch cut 10 Other (specify)   |    |   |                                                                          |                           |                          |
| SCREEN-PERFORATED INTERVALS: From <u>43</u> ft. to <u>55</u> ft., From <u>55</u> ft. to <u>70</u> ft.   |    |   |                                                                          |                           |                          |
| GRAVEL PACK INTERVALS: From <u>23</u> ft. to <u>70</u> ft., From <u>70</u> ft. to <u>70</u> ft.   |    |   |                                                                          |                           |                          |
| 6 GROUT MATERIAL: 1 Neat cement 2 Cement grout 3 <u>Bentonite</u> 4 Other   |    |   |                                                                          |                           |                          |
| Grout Intervals: From <u>3</u> ft. to <u>23</u> ft., From <u>23</u> ft. to <u>70</u> ft., From <u>70</u> ft. to <u>70</u> ft.   |    |   |                                                                          |                           |                          |
| What is the nearest source of possible contamination:   |    |   |                                                                          |                           |                          |
| 1 Septic tank 4 Lateral lines 7 Pit privy 10 Livestock pens 14 Abandoned water well<br>2 Sewer lines 5 Cess pool 8 Sewage lagoon 11 Fuel storage 15 Oil well/Gas well<br>3 Watertight sewer lines 6 Seepage pit 9 Feedyard 12 Fertilizer storage 16 Other (specify below)<br>13 Insecticide storage <u>50 ft west</u>   |    |   |                                                                          |                           |                          |
| Direction from well? <u>50 ft west</u>   |    |   |                                                                          |                           |                          |
| FROM TO LITHOLOGIC LOG FROM TO PLUGGING INTERVALS   |    |   |                                                                          |                           |                          |
| 0   | 2  | soil   |                                                                          |                           |                          |
| 2   | 9  | silt   |                                                                          |                           |                          |
| 9   | 22 | sand   |                                                                          |                           |                          |
| 22   | 32 | yellow clay   |                                                                          |                           |                          |
| 32   | 41 | sand   |                                                                          |                           |                          |
| 41   | 55 | sand some medium   |                                                                          |                           |                          |
| 55   | 60 | fine sand & clay   |                                                                          |                           |                          |
| 60   | 70 | clay   |                                                                          |                           |                          |
| 7 CONTRACTOR'S OR LANDOWNER'S CERTIFICATION: This water well was (1) constructed, (2) reconstructed, or (3) plugged under my jurisdiction and was completed on (mo/day/year) <u>7-27-98</u> and this record is true to the best of my knowledge and belief. Kansas Water Well Contractor's License No. <u>140</u> This Water Well Record was completed on (mo/day/yr) <u>8-15-98</u> under the business name of <u>Lyman Inc.</u> by (signature) <u>[Signature]</u> |    |   |                                                                          |                           |                          |
| INSTRUCTIONS: Use typewriter or ball point pen. PLEASE PRESS FIRMLY and PRINT clearly. Please fill in blanks, underline or circle the correct answers. Send top three copies to Kansas Department of Health and Environment, Bureau of Water, Topeka, Kansas 66620-0001. Telephone: 913-296-5545. Send one to WATER WELL OWNER and retain one for your records.   |    |   |                                                                          |                           |                          |

OFFICE USE ONLY

T

R

EW

SEC

1/4

1/4

1/4