


1 LOCATION OF WATER WELL:	Fraction	Section Number	Township Number	Range Number
County: Kingman	Near ¼ Center ¼ NE ¼	31	T 30 S	R 10 W

Distance and direction from nearest town or city street address of well if located within city?
3 miles South & 1 1/2 miles West of Nashville, KS

2 WATER WELL OWNER: Steve Hellman
RR#, St. Address, Box # : R.R.
City, State, ZIP Code : Nashville, KS 67112

Board of Agriculture, Division of Water Resources
Application Number: 31,659

3 LOCATE WELL'S LOCATION WITH AN "X" IN SECTION BOX: 4 DEPTH OF COMPLETED WELL... 60... ft. ELEVATION: ...
Depth(s) Groundwater Encountered 1... 12... ft 2... ft 3... ft

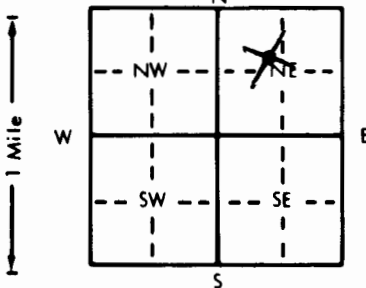

4 DEPTH OF COMPLETED WELL..... 60..... ft. ELEVATION:.....
 Depth(s) Groundwater Encountered 1..... 12..... ft. 2..... ft. 3..... ft.
 WELL'S STATIC WATER LEVEL... 12..... ft. below land surface measured on mo/day/yr 3-17-95.....
 Pump test data: Well water was..... ft. after..... hours pumping..... gpm
 Est. Yield 500-600 gpm: Well water was..... ft. after..... hours pumping..... gpm
 Bore Hole Diameter. 3.0..... in. to..... 60..... ft., and..... in. to..... ft.
 WELL WATER TO BE USED AS: 5 Public water supply 8 Air conditioning 11 Injection well
 1 Domestic 3 Feedlot 6 Oil field water supply 9 Dewatering 12 Other (Specify below)
2 Irrigation 4 Industrial 7 Lawn and garden only 10 Monitoring well.....
 Was a chemical/bacteriological sample submitted to Department? Yes..... No..... X.....; If yes, mo/day/yr sample was submitted.....
 Water Well Disinfected? Yes X No

5	TYPE OF BLANK CASING USED:		5 Wrought iron	8 Concrete tile	CASING JOINTS: Glued . ☒ . . . Clamped Welded Threaded
	1 Steel	3 RMP (SR)	6 Asbestos-Cement	9 Other (specify below)	
	2 PVC	4 ABS	7 Fiberglass		

Blank casing diameter . . . 16 . . . in. to . 20 . . . ft., Dia . . . in. to . . . ft., Dia . . . in. to . . . ft.
Casing height above land surface . . . 12 . . . in., weight . . . 16.15 . . . lbs./ft. Wall thickness or gauge No. . 50.0

TYPE OF SCREEN OR PERFORATION MATERIAL:			7 PVC	10 Asbestos-cement
1 Steel	3 Stainless steel	5 Fiberglass	8 RMP (SR)	11 Other (specify)
2 Brass	4 Galvanized steel	6 Concrete tile	9 ABS	12 None used (open hole)

SCREEN OR PERFORATION OPENINGS ARE:		5 Gauzed wrapped	8 Saw cut	11 None (open hole)
1 Continuous slot	3 Mill slot	6 Wire wrapped	9 Drilled holes	
2 Louvered shutter	4 Key punched	7 Torch cut	10 Other (specify)	

SCREEN-PERFORATED INTERVALS:	From	20	ft. to	60	ft., From	ft. to	ft.
	From		ft. to		ft., From	ft. to	ft.
GRAVEL PACK INTERVALS:	From	20	ft. to	60	ft., From	ft. to	ft.
	From		ft. to		ft., From	ft. to	ft.

6 GROUT MATERIAL: 1 Neat cement 2 Cement grout 3 Bentonite 4 Other
Grout intervals: From 0 ft. to 20 ft. From ft. to ft. From ft. to ft.

What is the nearest source of possible contamination: **None within 1/4 mile**

1 Septic tank	4 Lateral lines	7 Pit privy	10 Livestock pens	14 Abandoned water well
2 Sewer lines	5 Cess pool	8 Sewage lagoon	11 Fuel storage	15 Oil well/Gas well
3 Watertight sewer lines	6 Seepage pit	9 Feedyard	12 Fertilizer storage	16 Other (specify below)
			13 Insecticide storage	

Direction from well? _____ How many feet? _____

FROM	TO	LITHOLOGIC LOG	FROM	TO	PLUGGING INTERVALS
0	3	Top Soil			
3	10	Clay-Red			
10	24	Sand-Fine			
24	32	Sand-Very Fine			
32	33	Sand-Hard Fine			
33	36	Clay-Red			
36	38	Sand-Fine			
38	51	Sand & Clay Mixed			
51	59	Sand-Medium			
59	60	Shale-Red			

7 CONTRACTOR'S OR LANDOWNER'S CERTIFICATION: This water well was (1) constructed, (2) reconstructed, or (3) plugged under my jurisdiction and was completed on (mo/day/year) 3-17-95 and this record is true to the best of my knowledge and belief. Kansas Water Well Contractor's License No. 138 This Water Well Record was completed on (mo/day/yr) 3-28-95 under the business name of Peterson Irrigation Inc. by (signature) Mike Peterson