

CORRECTION(S) TO WATER WELL RECORD (WWC-5)  
(to rectify lacking or incorrect information)

County: Barber

Location listed as:

Section-Township-Range: \_\_\_\_\_

Fraction (  $\frac{1}{4}$   $\frac{1}{4}$   $\frac{1}{4}$ ): \_\_\_\_\_

Location ~~changed to:~~

33-30S-11W

C N2 NW

Other changes: Initial statements: Pratt County

Changed to: Barber County

Comments: \_\_\_\_\_

verification method: Written & legal descriptions, county ownership map, and mapping tool & aerial photos on KGS website.

initials: DRJ date: 9/22/2009


submitted by: Kansas Geological Survey, Data Resources Library, 1930 Constant Ave., Lawrence, KS 66047-3726  
to: Kansas Dept of Health & Environment, Bureau of Water, 1000 SW Jackson, Suite 420, Topeka, KS 66612-1367.

1 LOCATION OF WATER WELL: Fraction NE 1/4 NW Section Number 33 Township Number 30 Range Number 11 EAM

County: Draft

Distance and direction from nearest town or city street address of well if located within city?  
From Isabel, KS: 5 1/2 miles South & 3/4 mile East

2 WATER WELL OWNER: Cargill Ranch  
 RR #, St. Address, Box #: 8000 Isabel Rd  
 City, State, ZIP Code: Isabel, KS 67065 Board of Agriculture, Division of Water Resources  
 Application Number: \_\_\_\_\_

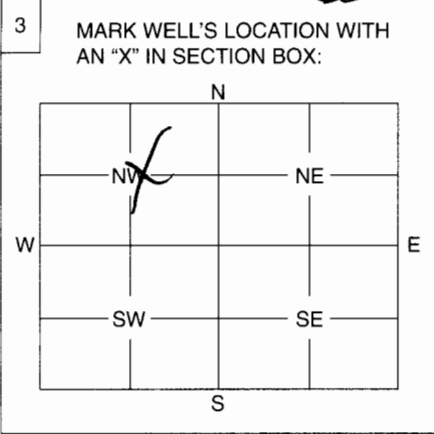

4 DEPTH OF WELL ..... 75 ft.  
 WELL'S STATIC WATER LEVEL ..... 75 ft.  
 WELL WAS USED AS:  
 1 Domestic  5 Public Water Supply  9 Dewatering   
 2  Irrigation  6 Oil Field Water Supply  10 Monitoring Well   
 3 Feedlot  7 Domestic (Lawn & Garden)  11 Injection Well   
 4 Industrial  8 Air Conditioning  12 Other .....  
 Was a chemical / bacteriological sample submitted to Department? Yes ..... No   
 If yes, mo/day/yr sample was submitted .....  
 Water Well Disinfected: Yes  No .....

5 TYPE OF BLANK CASING USED:  
 1 Steel  3 RMP (SR)  5 Wrought  7 Fiberglass  9 Other (Specify below) \_\_\_\_\_  
 2 PVC  4 ABS  6 Asbestos-Cement  8 Concrete Tile   
 Blank casing diameter ..... 16 in. Was casing pulled? Yes  No ..... If yes, how much 36"  
 Casing height above or below land surface ..... 36 in.

6 GROUT PLUG MATERIAL: 1 Neat cement  2 Cement grout  3  Bentonite  4 Other .....  
 Grout Plug Intervals: From 0 ft. to 3 ft., From 3 ft. to 25 ft., From 25 to 75 ft.  
 What is the nearest source of possible contamination:  
 1 Septic tank  6 Seepage pit  11 Fuel storage  16  Other (specify below) new well  
 2 Sewer lines  7 Pit privy  12 Fertilizer storage   
 3 Watertight sewer lines  8 Sewage lagoon  13 Insecticide storage   
 4 Lateral lines  9 Feedyard  14 Abandoned water well   
 5 Cess pool  10 Livestock pens  15 Oil well/Gas well   
 Direction from well? West How many feet? 75

FROM	TO	PLUGGING MATERIALS
<u>0</u>	<u>3</u>	<u>Top soil</u>
<u>3</u>	<u>25</u>	<u>Concrete</u>
<u>25</u>	<u>75</u>	<u>Sand</u>

7 CONTRACTOR'S OF LANDOWNER'S CERTIFICATION: This water well was plugged under my jurisdiction and was completed on (mo/day/year) ..... 5/26/09 ..... and this record is true to the best of my knowledge and belief. Kansas Water Well Contractor's License No. 238 This Water Well Record was completed on (mo/day/year) ..... 5/26/09 ..... under the business name of Premier Pump & Well Service by (signature) Curra Kuchubog

INSTRUCTIONS: Use typewriter or ball point pen. Please press firmly and print clearly. Please fill in blanks, underline or circle the correct answers. Send top three copies to Kansas Department of Health and Environment, Bureau of Water, Geology Section, 1000 SW Jackson St., Ste. 420, Topeka, Kansas 66612-1367. Telephone: 785/296-5522. Send one to Water Well Owner and retain one for your records.