USE TYPEWRITER OR BALL POINT PEN-PRESS FIRMLY, PRINT CLEARLY.

T R EW sec 1/4 1/4 1/4 No.

WATER WELL RECORD
KSA 82a-1201-1215

Kansas State Dept. Of Health
(Water Well Contractors)
Forbes-Bldg. 740
Topeka, Kansas 66620

1 Location of well:	County	Township name	Fraction	Section number	Town number	Range number
	Barber		C NW¼	6	30 S	12 W

Distance and direction from nearest town or city: 2 Mi South of Sawyer, Ks.

Street address of well location if in city:

3 Owner of well: Don Brubaker

Address: Sawyer, Kansas

Locate with "X" in section below:

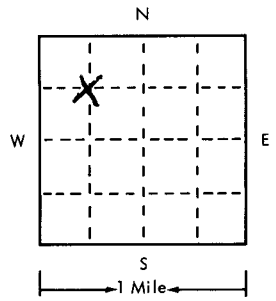

Sketch map:

4 Well depth: 192' ft. Date of completion 4/19/75
Well diameter 30 in.

5 ☐ Cable tool ☐ Rotary ☐ Driven ☐ Dug ☐ Hollow rod ☐ Jetted ☐ Bored ☒ Reverse rotary

6 Use: ☐ Domestic ☐ Public supply ☐ Industry ☒ Irrigation ☐ Air conditioning ☐ Commercial ☐ Test well ☐ _____

7 Casing: Material Stl Height: above/~~below~~
Threaded ☐ Welded ☒ Surface 12 in.
Diam. 16 in. to 136 ft. depth Weight 31.75 lbs./ft.
Drive shoe? ☐ Yes ☒ No
___ in. to ___ ft. depth

2 Type and color of material	From	To
Top soil	0	2
Clay	2	20
Med. sand & gravel	20	27
Clay	27	34
Med. sand & gravel	34	50
Clay	50	60
Med. sand & gravel	60	94
Clay	94	110
Med. sand & gravel with some clay	110	157
Clay	157	177
Fine sand & clay	177	186
Fine to coarse sand & med. gravel	186	193
Red shale	193	199
(use a second sheet if needed)		

8 Screen:
Manufacturer Doerr
Type Steel Dia. 16"
Slot/gauze 1/8 Length 56'
Set between 136 ft. and 192 ft.
Fittings:
Gravel pack ☒ Yes ☐ No Size range of material 1/8 x 3/8

9 Static water level:
76 ft. below land surface Date 4/19/75

10 Pumping level below land surfaces: No Test
___ ft. after ___ hrs. pumping ___ g.p.m.
___ ft. after ___ hrs. pumping ___ g.p.m.
Estimated maximum yield ___ g.p.m.

11 Water sample submitted:
☐ Yes ☒ No Date ___

12 Well head completion:
☐ Pitless adapter ☒ 12 Inches above grade

13 Well grouted? ☐ Yes ☒ No
☐ Neat cement ☐ Bentonite ☒ 10' of clay
Depth: From 0 ft. to 10 ft.

14 Nearest source of possible contamination:
ft 10000 Direction North Type City
Well disinfected upon completion? ☐ Yes ☒ No

15 Pump: ☐ Not installed
Manufacturer's name Singer-Layne
Model number 12 RK HP 80 Volts —
Length of drop pipe 120 ft. capacity 700 g.m.p.
Type:
☐ Submersible ☒ Turbine
☐ Jet ☐ Reciprocating
☐ Certrifugal ☐ Other

16 Remarks: elevation

Topography:
☐ Hill
☐ Slope
☒ Upland
☐ Valley

17 Water well contractor's certification:
This well was drilled under my jurisdiction and this report is true to the best of my knowledge and belief.
Layne Western Co. 102
Business name License No.
Address Wichita, Ks
Signed [signature] Date 4/21/75
Authorized representative

Forward the white, blue and pink copies to the Kansas State Dept. Of Health.

Form WWC-5

677-H