


1 LOCATION OF WATER WELL: County: ~~XXXXXX~~ Barber Fraction C 1/4 N 1/2 1/4 NE 1/4 Section Number 6 Township Number T 30 S Range Number R 12W E/W

Distance and direction from nearest town or city street address of well if located within city?
2 S, 3/4 E of Sawyer, Kansas

2 WATER WELL OWNER: Larry Thorne Sterling Drilling Co. Thorne #1
RR#, St. Address, Box #: Alva, Okl. Box 129 Board of Agriculture, Division of Water Resources
City, State, ZIP Code: Sterling, Kansas 67579 Application Number: 91004

3 LOCATE WELL'S LOCATION WITH AN "X" IN SECTION BOX:

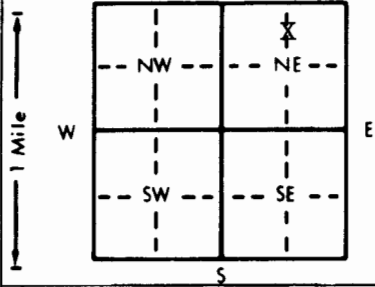

4 DEPTH OF COMPLETED WELL: 135 ft. ELEVATION: Unknown

Depth(s) Groundwater Encountered 1.75 ft. 2. ft. 3. ft.
WELL'S STATIC WATER LEVEL .75 ft. below land surface measured on mo/day/yr 12/27/90
Pump test data: Well water was . ft. after . hours pumping . gpm
Est. Yield .60 gpm: Well water was . ft. after . hours pumping . gpm
Bore Hole Diameter .8 in. to 1.35 ft., and . in. to . ft.
WELL WATER TO BE USED AS: 5 Public water supply 8 Air conditioning 11 Injection well
1 Domestic 3 Feedlot 6 Oil field water supply 9 Dewatering 12 Other (Specify below)
2 Irrigation 4 Industrial 7 Lawn and garden only 10 Monitoring well
Was a chemical/bacteriological sample submitted to Department? Yes.....No.....; If yes, mo/day/yr sample was submitted
Water Well Disinfected? Yes No

5 TYPE OF BLANK CASING USED: 1 Steel 3 RMP (SR) 5 Wrought iron 8 Concrete tile CASING JOINTS: Glued . Clamped .
2 PVC 4 ABS 6 Asbestos-Cement 9 Other (specify below) Welded .
7 Fiberglass Threaded .

Blank casing diameter .5 in. to 11.5 ft., Dia . in. to . ft., Dia . in. to . ft.
Casing height above land surface .12 in., weight .2.8 lbs./ft. Wall thickness or gauge No. Sch.40

TYPE OF SCREEN OR PERFORATION MATERIAL: 7 PVC 10 Asbestos-cement
1 Steel 3 Stainless steel 5 Fiberglass 8 RMP (SR) 11 Other (specify) .
2 Brass 4 Galvanized steel 6 Concrete tile 9 ABS 12 None used (open hole)

SCREEN OR PERFORATION OPENINGS ARE: 5 Gauzed wrapped 8 Saw cut 11 None (open hole)
1 Continuous slot 3 Mill slot 6 Wire wrapped 9 Drilled holes
2 Louvered shutter 4 Key punched 7 Torch cut 10 Other (specify) .

SCREEN-PERFORATED INTERVALS: From .115 ft. to 135 ft., From . ft. to . ft.
From . ft. to . ft., From . ft. to . ft.
GRAVEL PACK INTERVALS: From .20 ft. to 135 ft., From . ft. to . ft.
From . ft. to . ft., From . ft. to . ft.

6 GROUT MATERIAL: 1 Neat cement 2 Cement grout 3 Bentonite 4 Other .
Grout Intervals: From .0 ft. to 20 ft., From . ft. to . ft., From . ft. to . ft.

What is the nearest source of possible contamination:
1 Septic tank 4 Lateral lines 7 Pit privy 10 Livestock pens 14 Abandoned water well
2 Sewer lines 5 Cess pool 8 Sewage lagoon 11 Fuel storage 15 Oil well/Gas well
3 Watertight sewer lines 6 Seepage pit 9 Feedyard 12 Fertilizer storage 16 Other (specify below)
13 Insecticide storage
Direction from well? South How many feet? 60

FROM	TO	LITHOLOGIC LOG	FROM	TO	PLUGGING INTERVALS
0	50	Clay			
50	135	Sand and gravel with clay streaks			

7 CONTRACTOR'S OR LANDOWNER'S CERTIFICATION: This water well was (1) constructed, (2) reconstructed, or (3) plugged under my jurisdiction and was completed on (mo/day/year) 12/27/91 and this record is true to the best of my knowledge and belief. Kansas Water Well Contractor's License No. 186 This Water Well Record was completed on (mo/day/yr) 3/1/91 under the business name of Kelly's Water Well Service by (signature) [Signature]

OFFICE USE ONLY
T
R
EW
SEC.
1/4
1/4
1/4