USE TYPEWRITER OR BALL POINT PEN-PRESS FIRMLY, PRINT CLEARLY.

T R EW sec 1/4 1/4 1/4 No.

WATER WELL RECORD
KSA 82a-1201-1215

Kansas State Dept. Of Health
(Water Well Contractors)
Forbes-Bldg. 740
Topeka, Kansas 66620

1 Location of well:	County	Township name	Fraction	Section number	Town number	Range number
	Barber	Elm Mills	NENENE	15	T30S	R12W

Distance and direction from nearest town or city: 2E 3S 1/4E
Street address of well location if in city: 151E Sawyer

3 Owner of well: IUAN Boyd
Address: Sawyer, Kansas 67134

Locate with "X" in section below:

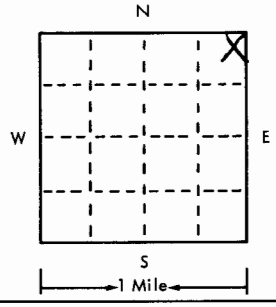

Sketch map:

4 Well depth: 112 ft. Date of completion 7-30-75
Well diameter 5 in.

5 ☐ Cable tool ☒ Rotary ☐ Driven ☐ Dug
☐ Hollow rod ☐ Jetted ☐ Bored ☐ Reverse rotary

6 Use: ☒ Domestic ☐ Public supply ☐ Industry
☐ Irrigation ☐ Air conditioning ☐ Commercial
☐ Test well ☐ _____

7 Casing: Material RMP Height: (above) below
Threaded ☐ Welded ☐ Surface 12 in.
Diam. Glue Weight 200 lbs./ft.
5 in. to 112 ft. depth Drive shoe? ☐ Yes ☒ No
___ in. to ___ ft. depth

2

Type and color of material	From	To
Earth	0	4
Gyp & Clay	4	15
Sand	15	30
Sand	30	45
Sand & rock	45	60
Rock	60	63
Course sand	63	94
Brown Clay	94	105
Sand	105	112
(use a second sheet if needed)		

8 Screen:
Manufacturer Jess & Lowell
Type RMP Dia. 5"
Slot/gauze 1/16 Length 20'
Set between 92 ft. and 112 ft.
Fittings:
Gravel pack ☒ Yes ☐ No Size range of material 1/16-3/8

9 Static water level:
71 ft. below land surface Date 7-30-75

10 Pumping level below land surfaces:
___ ft. after ___ hrs. pumping ___ g.p.m.
___ ft. after ___ hrs. pumping ___ g.p.m.
Estimated maximum yield 100 g.p.m.

11 Water sample submitted:
☐ Yes ☒ No Date _____

12 Well head completion: 12"
☒ Pitless adapter ☐ Inches above grade

13 Well grouted? ☒ Yes ☐ No
☒ Neat cement ☐ Bentonite ☐ _____
Depth: From 4 ft. to 14 ft.

14 Nearest source of possible contamination:
ft. 125 Direction N Type Septic Tank
Well disinfected upon completion? ☒ Yes ☐ No

15 Pump: ☐ Not installed
Manufacturer's name Reda
Model number 100 18P 101 HP 1 Volts 230
Length of drop pipe 102 ft. capacity 25 g.m.p.
Type:
☒ Submersible ☐ Turbine
☐ Jet ☐ Reciprocating
☐ Centrifugal ☐ Other

16 Remarks: elevation

Topography:
☒ Hill
☐ Slope
☐ Upland
☐ Valley

17 Water well contractor's certification:
This well was drilled under my jurisdiction and this report is true to the best of my knowledge and belief.
Hank Bruse Well Service 103
Business name License No.
Address 417 Stout
Signed Jerry Bruse Date 8-21-75
Authorized representative

Forward the white, blue and pink copies to the Kansas State Dept. Of Health.

Form WWC-5

677-H