


1 LOCATION OF WATER WELL: Barber	FRACTION C of NE 1/4 SE 1/4	Section Number 3	Township Number T 30 S	Range Number R 13W E/W
--	--------------------------------	----------------------------	----------------------------------	----------------------------------

Distance and direction from nearest town or city street address of well if located within city?
2 m. S., 2 1/2 W., 5/8 S., 3/8 E. of Sawyer, Kansas

2 WATER WELL OWNER: HOLL CO., F.G. RR#, ST. ADDRESS, BOX #: Box 158 CITY, STATE, ZIP CODE: Belpre, Kansas 67519	Board of Agriculture, Division of Water Resource Application Number:
--	---

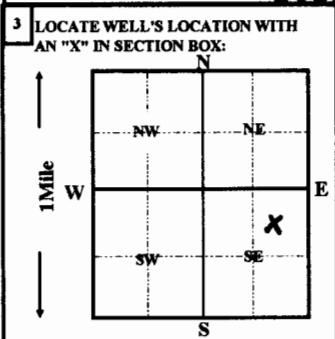

4 DEPTH OF COMPLETED WELL 18 ft. ELEVATION:	ft. 2 ft. 3 ft.
Depth(s) groundwater Encountered 1 ft. 2 ft. 3 ft.	
WELL'S STATIC WATER LEVEL 6 FT. BELOW LAND SURFACE MEASURED ON 01/25/1994	
Pump test data: Well water was _____ ft. after _____ hours pumping _____ gpm	
Est. Yield _____ gpm: Well water was _____ ft. after _____ hours pumping _____ gpm	
Bore Hole Diameter 8 in. to _____ ft., and _____ in. to _____ ft.	
WELL WATER TO BE USED AS:	
1 Domestic 3 Feedlot 6 Oil field water supply 9 Dewatering 12 Other (Specify below)	
2 Irrigation 4 Industrial 7 Lawn and garden only 10 Monitoring well	
Was a chemical/bacteriological sample submitted to Department? Yes _____ No <input checked="" type="checkbox"/> ; If yes, mo/day/yr sample was submitted _____	Water Well Disinfected? Yes <input checked="" type="checkbox"/> No

5 TYPE OF CASING USED:	5 Wrought iron	8 Concrete tile	CASING JOINTS:	Glued	Clamped
1 Steel 3 RMP (SR)	6 Asbestos-Cement	9 Other (Specify below)		Welded	
2 PVC 4 ABS	7 Fiberglass			Threaded	<input checked="" type="checkbox"/>
Blank casing Diameter 2 in. to _____ ft., Dia _____ in. to _____ ft.	weight .703 lbs. / ft.	Wall thickness or gauge No. .154			
Casing height above land surface 24 in.,					
TYPE OF SCREEN OR PERFORATION MATERIAL:					
1 Steel 3 Stainless Steel	5 Fiberglass	8 RMP (SR)		11 other (specify)	
2 Brass 4 Galvanized steel	6 Concrete tile	9 ABS		12 None used (open hole)	
SCREEN OR PERFORATION OPENING ARE:	5 Gauzed wrapped	8 Saw cut		11 None (open hole)	
1 Continuous slot 3 Mill slot	6 Wire wrapped	9 Drilled holes			
2 Louvered shutter 4 Key punched	7 Torch cut	10 Other (specify)			
SCREEN-PERFORATION INTERVALS: from 8 ft. to 18 ft., From _____ ft. to _____ ft.					
GRAVEL PACK INTERVALS: from 6 ft. to 18 ft., From _____ ft. to _____ ft.					

6 GROUT MATERIAL:	1 Neat cement	2 Cement grout	3 Bentonite	4 Other
Grout Intervals: From _____ ft. to _____ ft., From _____ ft. to _____ ft.				
What is the nearest source of possible contamination:				
1 Septic tank 4 Lateral lines	7 Pit privy	10 Livestock pens	14 Abandon water well	
2 Sewer lines 5 Cess pool	8 Sewage lagoon	11 Fuel storage	15 Oil well/Gas well	
3 Watertight sewer lines 6 Seepage pit	9 Feedyard	12 Fertilizer storage	16 Other (specify below)	
		13 Insecticide storage	None Apparent	

Direction from well?		How many feet?			
FROM	TO	LITHOLOGIC LOG		GROUT INTERVALS	
0	2	topsoil	0	4	cement and bentonite grout
2	5	sandy clay	4	6	bentonite hole plug
5	20	medium sand			

7 CONTRACTOR'S OR LANDOWNER'S CERTIFICATION: This water well was (1) constructed, (2) reconstructed, or (3) plugged under my jurisdiction and was completed on (mo/day/year) 01/25/1994 and this record is true to the best of my knowledge and belief. Kansas Water Well Contractor's License No. 236 This Water Well Record was completed on (mo/day/yr) 01/28/94 Under the business name of Harp Well & Pump by (signature) <i>Jane Frederick</i>
--