


1 LOCATION OF WATER WELL: Barber	FRACTION C of NE SE 1/4 1/4	Section Number 3	Township Number T 30 S	Range Number R 13W E/W
--	-----------------------------------	----------------------------	----------------------------------	----------------------------------

Distance and direction from nearest town or city street address of well if located within city?

2 m. S., 2 1/2 W., 5/8 S., 3/8 E. of Sawyer, Kansas

2 WATER WELL OWNER: HOLL CO., F.G. RR#, ST. ADDRESS, BOX #: Box 158 CITY, STATE, ZIP CODE: Belpre, Kansas 67519	Board of Agriculture, Division of Water Resource Application Number:
--	---

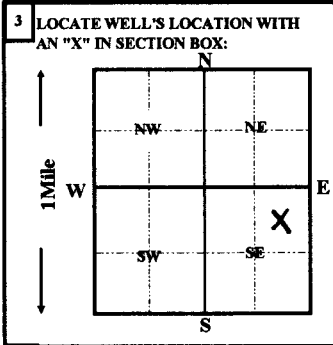

4 DEPTH OF COMPLETED WELL 18 ft. ELEVATION: Depth(s) groundwater Encountered 1 ft. 2 ft. 3 ft. WELL'S STATIC WATER LEVEL 6 FT. BELOW LAND SURFACE MEASURED ON 01/25/1994 mo/day/yr	Pump test data: Well water was _____ ft. after _____ hours pumping _____ gpm Est. Yield _____ gpm: Well water was _____ ft. after _____ hours pumping _____ gpm Bore Hole Diameter 8 in. to _____ ft., and _____ in. to _____ ft. WELL WATER TO BE USED AS: 5 Public water supply 8 Air conditioning 11 Injection well 1 Domestic 3 Feedlot 6 Oil field water supply 9 Dewatering 12 Other (Specify below) 2 Irrigation 4 Industrial 7 Lawn and garden only 10 Monitoring well Was a chemical/bacteriological sample submitted to Department? Yes _____ No <input checked="" type="checkbox"/> ; If yes, mo/day/yr sample was submitted _____ Water Well Disinfected? Yes <input checked="" type="checkbox"/> No _____
---	---

5 TYPE OF CASING USED: 1 Steel 3 RMP (SR) 2 PVC 4 ABS Blank casing Diameter 2 in. to _____ ft., Dia _____ in. to _____ ft. Casing height above land surface 24 in., weight .703 lbs. / ft. Wall thickness or gauge No. .154	5 Wrought iron 8 Concrete tile CASING JOINTS: Glued Clamped 6 Asbestos-Cement 9 Other (Specify below) Welded 7 Fiberglass Threaded <input checked="" type="checkbox"/>	TYPE OF SCREEN OR PERFORATION MATERIAL: 1 Steel 3 Stainless Steel 5 Fiberglass 8 RMP (SR) 11 other (specify) 2 Brass 4 Galvanized steel 6 Concrete tile 9 ABS 12 None used (open hole) SCREEN OR PERFORATION OPENING ARE: 1 Continuous slot 3 Mill slot 5 Gauzed wrapped 8 Saw cut 11 None (open hole) 2 Louvered shutter 4 Key punched 6 Wire wrapped 9 Drilled holes 7 Torch cut 10 Other (specify)
SCREEN-PERFORATION INTERVALS: from 8 ft. to 18 ft., From _____ ft. to _____ ft.	GRAVEL PACK INTERVALS: from 6 ft. to 18 ft., From _____ ft. to _____ ft.	

6 GROUT MATERIAL: 1 Neat cement 2 Cement grout 3 Bentonite 4 Other Grout Intervals: From _____ ft. to _____ ft., From _____ ft. to _____ ft.	What is the nearest source of possible contamination: 1 Septic tank 4 Lateral lines 7 Pit privy 10 Livestock pens 14 Abandon water well 2 Sewer lines 5 Cess pool 8 Sewage lagoon 11 Fuel storage 15 Oil well/Gas well 3 Watertight sewer lines 6 Seepage pit 9 Feedyard 12 Fertilizer storage 16 Other (specify below) 13 Insecticide storage None Apparent	Direction from well? _____ How many feet? _____ FROM TO LITHOLOGIC LOG FROM TO GROUT INTERVALS
---	---	---

FROM	TO	LITHOLOGIC LOG	FROM	TO	GROUT INTERVALS
0	2	topsoil	0	4	cement and bentonite grout
2	5	sandy clay	4	6	bentonite hole plug
5	18	medium silty sand			
18	20	gray clay			

7 CONTRACTOR'S OR LANDOWNER'S CERTIFICATION: This water well was (1) <u>constructed</u> , (2) reconstructed, or (3) plugged under my jurisdiction and was completed on (mo/day/year) <u>01/25/1994</u> and this record is true to the best of my knowledge and belief. Kansas Water Well Contractor's License No. <u>236</u> This Water Well Record was completed on (mo/day/yr) <u>01/28/94</u> Under the business name of <u>Harp Well & Pump</u> by (signature) <i>Jane Frederick</i>
--