


1 LOCATION OF WATER WELL: Fraction  $w\frac{1}{2}$   $\frac{1}{4}$  SW  $\frac{1}{4}$  NW  $\frac{1}{4}$  Section Number 4 Township Number T 30 S Range Number R 13 **E/W**  
 County: Barber

Distance and direction from nearest town or city street address of well if located within city?  
 Sawyer 4W 2S

2 WATER WELL OWNER: Don Lanbertt Sterling Drlg.  
 RR#, St. Address, Box #: Coats, Ks. 67028 Box 129  
 City, State, ZIP Code: Sterling, Ks. 67579 Board of Agriculture, Division of Water Resources  
 Application Number: T89-318

3 LOCATE WELL'S LOCATION WITH AN "X" IN SECTION BOX:

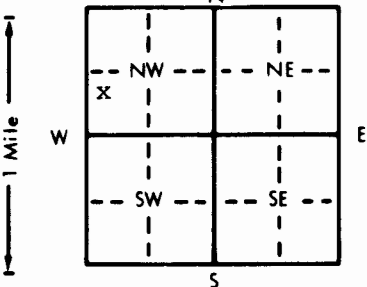

4 DEPTH OF COMPLETED WELL: 122 ft. ELEVATION: Unknown  
 Depth(s) Groundwater Encountered 1. 70 ft. 2. ft. 3. ft.  
 WELL'S STATIC WATER LEVEL: 70 ft. below land surface measured on mo/day/yr 7/11/89  
 Pump test data: Well water was ft. after hours pumping gpm  
 Est. Yield 100 gpm: Well water was ft. after hours pumping gpm  
 Bore Hole Diameter 8 in. to 122 ft., and in. to ft.  
 WELL WATER TO BE USED AS:  
 5 Public water supply 8 Air conditioning 11 Injection well  
 1 Domestic 3 Feedlot 6 Oil field water supply 9 Dewatering 12 Other (Specify below)  
 2 Irrigation 4 Industrial 7 Lawn and garden only 10 Monitoring well  
 Was a chemical/bacteriological sample submitted to Department? Yes No **X**; If yes, mo/day/yr sample was submitted  
 Water Well Disinfected? Yes No **X**

5 TYPE OF BLANK CASING USED:  
 1 Steel 3 RMP (SR) 5 Wrought iron 8 Concrete tile CASING JOINTS: Glued **X** Clamped  
 2 PVC 4 ABS 6 Asbestos-Cement 9 Other (specify below) Welded  
 7 Fiberglass Threaded

Blank casing diameter 5 in. to 102 ft., Dia in. to ft., Dia in. to ft.  
 Casing height above land surface 12 in., weight 2.8 lbs./ft. Wall thickness or gauge No. Sch. 40

TYPE OF SCREEN OR PERFORATION MATERIAL:  
 1 Steel 3 Stainless steel 5 Fiberglass 8 RMP (SR) 10 Asbestos-cement  
 2 Brass 4 Galvanized steel 6 Concrete tile 9 ABS 11 Other (specify)  
 12 None used (open hole)

SCREEN OR PERFORATION OPENINGS ARE:  
 1 Continuous slot 3 Mill slot 5 Gauzed wrapped 8 Saw cut 11 None (open hole)  
 2 Louvered shutter 4 Key punched 6 Wire wrapped 9 Drilled holes  
 7 Torch cut 10 Other (specify)

SCREEN-PERFORATED INTERVALS: From 102 ft. to 122 ft., From ft. to ft.  
 GRAVEL PACK INTERVALS: From 20 ft. to 122 ft., From ft. to ft.

6 GROUT MATERIAL: 1 Neat cement 2 Cement grout 3 Bentonite 4 Other  
 Grout Intervals: From 0 ft. to 20 ft., From ft. to ft., From ft. to ft.

What is the nearest source of possible contamination:  
 1 Septic tank 4 Lateral lines 7 Pit privy 11 Fuel storage 14 Abandoned water well  
 2 Sewer lines 5 Cess pool 8 Sewage lagoon 12 Fertilizer storage 15 Oil well/Gas well  
 3 Watertight sewer lines 6 Seepage pit 9 Feedyard 13 Insecticide storage 16 Other (specify below)

Direction from well? Northwest How many feet? 200

FROM	TO	LITHOLOGIC LOG	FROM	TO	PLUGGING INTERVALS
0	20	Top soil & clay			
20	122	Sand & gravel			

7 CONTRACTOR'S OR LANDOWNER'S CERTIFICATION: This water well was (1) constructed, (2) reconstructed, or (3) plugged under my jurisdiction and was completed on (mo/day/year) 7/11/89 and this record is true to the best of my knowledge and belief. Kansas  
 Water Well Contractor's License No. 186 This Water Well Record was completed on (mo/day/yr) 8/12/89  
 under the business name of Kelly's Water Well by (signature) *Don Lanbertt*

OFFICE USE ONLY  
 T  
 R  
 EW  
 SEC.  
 1/4  
 1/4  
 1/4