


1 LOCATION OF WATER WELL: County: Barber Fraction: SW 1/4 NW 1/4 SE 1/4 Section Number: 11 Township Number: T 30 S Range Number: R 14 W EW

Distance and direction from nearest town or city street address of well if located within city? 3 1/2 south of Coats 1 mile east

2 WATER WELL OWNER: Boyd Statts RR#, St. Address, Box #: 540 Sunrise Ave City, State, ZIP Code: Pwatt, Ks. 67124 Board of Agriculture, Division of Water Resources Application Number:

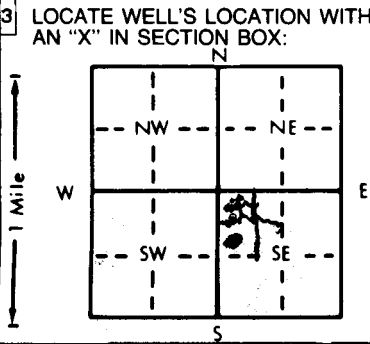

4 DEPTH OF COMPLETED WELL: 70 ft. ELEVATION: Depth(s) Groundwater Encountered: 1. 52 ft. 2. ft. 3. ft. WELL'S STATIC WATER LEVEL: 13 1/2 ft. below land surface measured on mo/day/yr 11-22-98 Pump test data: Well water was ft. after hours pumping gpm Est. Yield: 50 gpm Well water was ft. after hours pumping gpm Bore Hole Diameter: 9 in. to 70 ft., and in. to ft. WELL WATER TO BE USED AS: 5 Public water supply 8 Air conditioning 11 Injection well 1 Domestic 3 Feedlot 6 Oil field water supply 9 Dewatering 12 Other (Specify below) 2 Irrigation 4 Industrial 7 Lawn and garden only 10 Monitoring well Was a chemical/bacteriological sample submitted to Department? Yes No; If yes, mo/day/yr sample was submitted Water Well Disinfected? Yes No

5 TYPE OF BLANK CASING USED: 1 Steel 2 PVC 3 RMP (SR) 4 ABS 5 Wrought iron 6 Asbestos-Cement 7 Fiberglass 8 Concrete tile 9 Other (specify below) CASING JOINTS: Glued Clamped Welded Threaded Blank casing diameter: 5 in. to 57 ft., Dia. in. to ft., Dia. in. to ft. Casing height above land surface: 24 in., weight lbs./ft. Wall thickness or gauge No. 250 TYPE OF SCREEN OR PERFORATION MATERIAL: 1 Steel 2 Brass 3 Stainless steel 4 Galvanized steel 5 Fiberglass 6 Concrete tile 7 PVC 8 RMP (SR) 9 ABS 10 Asbestos-cement 11 Other (specify) 12 None used (open hole) SCREEN OR PERFORATION OPENINGS ARE: 1 Continuous slot 2 Louvered shutter 3 Mill slot 4 Key punched 5 Gauzed wrapped 6 Wire wrapped 7 Torch cut 8 Saw cut 9 Drilled holes 11 None (open hole) 10 Other (specify) SCREEN-PERFORATED INTERVALS: From 57 ft. to 62 ft., From ft. to ft., From ft. to ft., From ft. to ft. GRAVEL PACK INTERVALS: From 23 ft. to 70 ft., From ft. to ft., From ft. to ft., From ft. to ft.

6 GROUT MATERIAL: 1 Neat cement 2 Cement grout 3 Bentonite 4 Other Grout Intervals: From 3 ft. to 23 ft., From ft. to ft., From ft. to ft., From ft. to ft. What is the nearest source of possible contamination: 1 Septic tank 2 Sewer lines 3 Watertight sewer lines 4 Lateral lines 5 Cess pool 6 Seepage pit 7 Pit privy 8 Sewage lagoon 9 Feedyard 10 Livestock pens 11 Fuel storage 12 Fertilizer storage 13 Insecticide storage 14 Abandoned water well 15 Oil well/Gas well 16 Other (specify below) Direction from well? SW How many feet? 200

FROM	TO	LITHOLOGIC LOG	FROM	TO	PLUGGING INTERVALS
0	4	soil			
4	11	clay			
11	22	sand			
22	26	clay			
26	52	fine sand			
52	62	sand			
62	70	red shale			

7 CONTRACTOR'S OR LANDOWNER'S CERTIFICATION: This water well was (1) constructed, (2) reconstructed, or (3) plugged under (1) my jurisdiction and was completed on (mo/day/year) 11-22-98 and this record is true to the best of my knowledge and belief. Kansas Water Well Contractor's License No. 140 This Water Well Record was completed on (mo/day/yr) 12-10-98 under the business name of Lyman Inc. by (signature) [Signature]