


WATER WELL RECORD Form WWC-5 KSA 82a-1212

1 LOCATION OF WATER WELL: County: Barber Fraction: C 1/4 SW 1/4 SE 1/4 Section Number: 3 Township Number: T 30 S Range Number: R 14 -EW

Distance and direction from nearest town or city street address of well if located within city?
7 north 1/2 west of Lake City

2 WATER WELL OWNER: K. W. Ayres Wheatstate Drilling
 RR#, St. Address, Box #: Pratt, Ks. Box 947
 City, State, ZIP Code: Pratt, Ks. 67124 Board of Agriculture, Division of Water Resources
 Application Number: T83-398

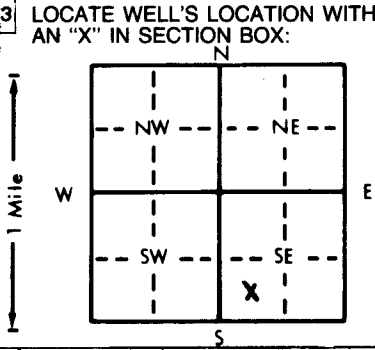

4 DEPTH OF COMPLETED WELL: 100 ft. ELEVATION: _____
 Depth(s) Groundwater Encountered: 1. 45 ft. 2. _____ ft. 3. _____ ft.
 WELL'S STATIC WATER LEVEL: 70 ft. below land surface measured on mo/day/yr 9-6-83
 Pump test data: Well water was _____ ft. after _____ hours pumping _____ gpm
 Est. Yield: NA gpm: Well water was _____ ft. after _____ hours pumping _____ gpm
 Bore Hole Diameter: 10 in. to 100 ft., and _____ in. to _____ ft.
 WELL WATER TO BE USED AS:
 5 Public water supply 8 Air conditioning 11 Injection well
 1 Domestic 3 Feedlot 6 Oil field water supply 9 Dewatering 12 Other (Specify below)
 2 Irrigation 4 Industrial 7 Lawn and garden only 10 Observation well
 Was a chemical/bacteriological sample submitted to Department? Yes _____ No: x _____; If yes, mo/day/yr sample was sub-
 mitted _____ Water Well Disinfected? Yes HTH No _____

5 TYPE OF BLANK CASING USED:
 1 Steel 3 RMP (SR) 5 Wrought iron 8 Concrete tile CASING JOINTS: Glued x Clamped _____
 2 PVC 4 ABS 6 Asbestos-Cement 9 Other (specify below) Welded _____
 7 Fiberglass Threaded _____
 Blank casing diameter: 5 in. to 80 ft., Dia _____ in. to _____ ft., Dia _____ in. to _____ ft.
 Casing height above land surface: 18 in., weight _____ lbs./ft. Wall thickness or gauge No. 25.8
 TYPE OF SCREEN OR PERFORATION MATERIAL:
 1 Steel 3 Stainless steel 5 Fiberglass 7 PVC 10 Asbestos-cement
 2 Brass 4 Galvanized steel 6 Concrete tile 8 RMP (SR) 11 Other (specify) _____
 9 ABS 12 None used (open hole)
 SCREEN OR PERFORATION OPENINGS ARE:
 1 Continuous slot 3 Mill slot 5 Gauzed wrapped 8 Saw cut 11 None (open hole)
 2 Louvered shutter 4 Key punched 6 Wire wrapped 7 Drilled holes 9 Other (specify) _____
 7 Torch cut 10 Other (specify) _____
 SCREEN-PERFORATED INTERVALS: From 80 ft. to 100 ft., From _____ ft. to _____ ft.
 From _____ ft. to _____ ft., From _____ ft. to _____ ft.
 GRAVEL PACK INTERVALS: From 10 ft. to 100 ft., From _____ ft. to _____ ft.
 From _____ ft. to _____ ft., From _____ ft. to _____ ft.

6 GROUT MATERIAL: 1 Neat cement 2 Cement grout 3 Bentonite 4 Other _____
 Grout Intervals: From 0 ft. to 10 ft., From _____ ft. to _____ ft., From _____ ft. to _____ ft.
 What is the nearest source of possible contamination:
 1 Septic tank 4 Lateral lines 7 Pit privy 10 Livestock pens 14 Abandoned water well
 2 Sewer lines 5 Cess pool 8 Sewage lagoon 11 Fuel storage 15 Oil well/Gas well
 3 Watertight sewer lines 6 Seepage pit 9 Feedyard 12 Fertilizer storage 16 Other (specify below)
 13 Insecticide storage
 Direction from well? east How many feet? 80

FROM	TO	LITHOLOGIC LOG	FROM	TO	LITHOLOGIC LOG
0	3	Top soil			
3	5	Clay			
5	11	Sand			
11	20	Clay			
20	31	Dry sand and gravel			
31	40	Clay			
40	95	Good clean sand and gravel			
95	100	Red bed			

7 CONTRACTOR'S OR LANDOWNER'S CERTIFICATION: This water well was (1) constructed, (2) reconstructed, or (3) plugged under my jurisdiction and was completed on (mo/day/year) 9-6-83 and this record is true to the best of my knowledge and belief. Kansas Water Well Contractor's License No. 134 This Water Well Record was completed on (mo/day/yr) 9-16-83 under the business name of Rosenkrantz-Bemis Ent. by (signature) Dora Dodson

INSTRUCTIONS: Use typewriter or ball point pen, PLEASE PRESS FIRMLY and PRINT clearly. Please fill in blanks, underline or circle the correct answers. Send top three copies to Kansas Department of Health and Environment, Division of Environment, Environmental Geology Section, Topeka, KS 66620. Send one to WATER WELL OWNER and retain one for your records.

OFFICE USE ONLY
 T 30
 R 14
 E W
 SEC 3
 C 1/4
 SW 1/4
 SE 1/4