


WATER WELL RECORD Form WWC-5 KSA 82a-1212

1 LOCATION OF WATER WELL: Fraction Section Number Township Number Range Number  
 COUNTY: 076 ~~PRATT~~ ~~BARBER~~ NE 1/4 SW 1/4 NW 1/4 2 T 30 S R 15 W

Distance and direction from nearest town or city street address of well if located within city?  
 3 E. 2 S. OF CROFT. KS.

2 WATER WELL OWNER: WILLIAM LEE 359 Board of Agriculture, Division of Water Resources  
 RR#, St. Address, Box #: RT.1  
 City, State, ZIP code: COATS, KS 67028- Application Number:

3 LOCATE WELL'S LOCATION WITH AN "X" IN SECTION BOX:

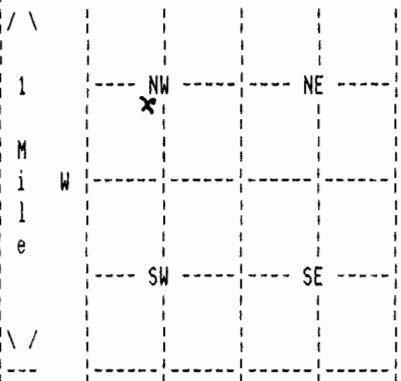

4 DEPTH OF COMPLETED WELL 48 ELEVATION: 0  
 Depth(s) Groundwater Encountered 1. 24 ft. 2. 0 ft. 3. 0 ft.

WELL'S STATIC WATER LEVEL 24 ft. below land surface measured on mo/day/yr  
 Pump test data: Well water was 0 ft. after 0 hours pumping 0 gpm

Estimated Yield 0 gpm: Well water was 0 ft. after 0 hours pumping 0 gpm

Bore Hole Diameter 8.75 in. to 48 ft., and in. to 0 ft.

WELL WATER TO BE USED AS: 01 DOMESTIC

Was a chemical/bacteriological sample submitted to department? No ;  
 If yes, mo/day/yr sample was submitted Water well disinfected? Yes

5 TYPE OF BLANK CASING USED: 02 PVC CASING JOINTS: GLUED  
 Blank casing diameter 5 in. to 38 ft., Dia in. to 0 ft., Dia in. to 0 ft.  
 Casing height above land surface 12 in., weight 0 lbs/ft. Wall thickness or gauge No. 26  
 TYPE OF SCREEN OR PERFORATION MATERIAL: 07 PVC  
 SCREEN OR PERFORATION OPENINGS ARE: 08 SAW CUT

SCREEN PERFORATED INTERVALS: From 38 ft. to 48 ft., From 0 ft. to 0 ft.  
 From 0 ft. to 0 ft., From 0 ft. to 0 ft.  
 GRAVEL PACK INTERVALS: From 48 ft. to 38 ft., From 0 ft. to 0 ft.  
 From 30 ft. to 23 ft., From 0 ft. to 0 ft.

6 GROUT MATERIAL 03 BENTONITE  
 Grout Intervals: From 38 ft. to 30 ft., From 23 ft. to 3 ft., From 0 ft. to 0 ft.  
 What is the nearest source of possible contamination: 10 LIVEST. PENS  
 Direction from well? NW How many feet? 50

FROM	TO	LITHOLOGIC LOG	FROM	TO	PLUGGING INTERVALS
0	7	TAN CLAY			
7	16	05 SAND AND 17 GRAVEL			
16	21	TAN CLAY			
21	28	BLACK CLAY			
28	33	05 SAND AND 17 GRAVEL			
33	38	BLACK CLAY			
38	48	17 GRAVEL			
48	50	RED CLAY			

7 CONTRACTOR'S OR LANDOWNER'S CERTIFICATION: This water well was Constructed under my jurisdiction and was completed on (mo/day/year) 4 /19/96 and this record is true to the best of my knowledge and belief. Kansas Water Well Contractor's License No. 224 This Water Well Record was completed on (mo/day/yr) 05/31/96 under the business name of CARL HAYSE WATER WELL SVC by (signature) Carl Hayse