

WATER WELL RECORD

Form WWC-5

Division of Water Resources App. No.


[]

1 LOCATION OF WATER WELL:
 County: BARBER Fraction 1/4 NE 1/4 NE 1/4 SE 1/4 Section Number 28 Township No. T 30 S Range Number R 15 []E [x]W

Street/Rural Address of Well Location; if unknown, distance & direction from nearest town or intersection: If at owner's address, check here [].

Global Positioning System (GPS) information:
 Latitude: (in decimal degrees)
 Longitude: (in decimal degrees)
 Elevation:
 Datum: [] WGS 84, [] NAD 83, [] NAD 27
 Collection Method:
 [] GPS unit (Make/Model:)
 [] Digital Map/Photo, [] Topographic Map, [] Land Survey
 Est. Accuracy: [] <3 m, [] 3-5 m, [] 5-15 m, [] >15 m

2 WATER WELL OWNER: ED BRICKER
 RR#, Street Address, Box #: P.O. BOX 246
 City, State, ZIP Code : CHEROKEE, OK 73728

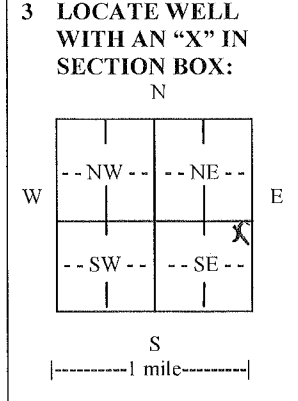

4 DEPTH OF COMPLETED WELL 40 ft.
 Depth(s) Groundwater Encountered (1)..... ft. (2)..... ft. (3)..... ft.
 WELL'S STATIC WATER LEVEL 15 ft. below land surface measured on mo/day/yr. 5/23/13
 Pump test data: Well water was ft. after hours pumping gpm
 EST. YIELD gpm. Well water was ft. after hours pumping gpm
 Bore Hole Diameter 10 5/8 in. to 40 ft., and in. to ft.
 WELL WATER TO BE USED AS: [] Public water supply [] Geothermal [] Injection well
 [x] Domestic [] Feedlot [] Oil field water supply [] Dewatering [] Other (Specify below)
 [] Irrigation [] Industrial [] Domestic-lawn & garden [] Monitoring well
 Was a chemical/bacteriological sample submitted to Department? [] Yes [x] No
 If yes, mo/day/yr sample was submitted.....
 Water well disinfected? [x] Yes [] No

5 TYPE OF CASING USED: [] Steel [x] PVC [] Other
 CASING JOINTS: [x] Glued [] Clamped [] Welded [] Threaded
 Casing diameter 5 in. to 40 ft., Diameter in. to ft., Diameter in. to ft.
 Casing height above land surface 36 in., Weight lbs./ft., Wall thickness or gauge No. SDR17
 TYPE OF SCREEN OR PERFORATION MATERIAL:
 [] Steel [] Stainless Steel [x] PVC [] Other (Specify)
 [] Brass [] Galvanized Steel [] None used (open hole)
 SCREEN OR PERFORATION OPENINGS ARE:
 [] Continuous slot [x] Mill slot [] Gauze wrapped [] Torch cut [] Drilled holes [] None (open hole)
 [] Louvered shutter [] Key punched [] Wire wrapped [] Saw cut [] Other (specify)
 SCREEN-PERFORATED INTERVALS: From 15 ft. to 40 ft., From ft. to ft.
 From ft. to ft., From ft. to ft.
 GRAVEL PACK INTERVALS: From 15 ft. to 40 ft., From ft. to ft.
 From ft. to ft., From ft. to ft.

6 GROUT MATERIAL: [] Neat cement [] Cement grout [x] Bentonite [] Other
 Grout Intervals: From 0 ft. to 15 ft., From ft. to ft., From ft. to ft.
 What is the nearest source of possible contamination:
 [] Septic tank [] Lateral lines [] Pit privy [] Livestock pens [] Insecticide storage [x] Other (specify below)
 [] Sewer lines [] Cesspool [] Sewage lagoon [] Fuel storage [] Abandoned water well
 [] Watertight sewer lines [] Seepage pit [] Feedyard [] Fertilizer storage [] Oil well/gas well NONE
 Direction from well N/A Distance from well N/A

FROM	TO	LITHOLOGIC LOG	FROM	TO	LITHO. LOG (cont.) or PLUGGING INTERVALS
0	5	TOPSOIL			
5	10	RED CLAY			
10	15	RED CLAY/SAND			
15	40	HEAVY GRAVEL			

7 CONTRACTOR'S OR LANDOWNER'S CERTIFICATION: This water well was [x] constructed, [] reconstructed, or [] plugged under my jurisdiction and was completed on (mo/day/year) 5/23/13 and this record is true to the best of my knowledge and belief. Kansas Water Well Contractor's License No. 864 This Water Well Record was completed on (mo/day/year) 5/23/13 under the business name of CRESCENT SERVICES, LLC by (signature) [Signature]

INSTRUCTIONS: Use typewriter or ball point pen. PLEASE PRESS FIRMLY and PRINT clearly. Please fill in blanks and check the correct answers. Send one copy to Kansas Department of Health and Environment, Bureau of Water, Geology Section, 1000 SW Jackson St., Suite 420, Topeka, Kansas 66612-1367. Telephone 785-296-5524. Send one copy to WATER WELL OWNER and retain one for your records. Include fee of \$5.00 for each constructed well. Visit us at <http://www.kdheks.gov/waterwell/index.html>