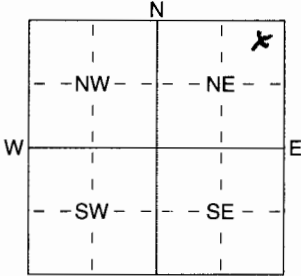


1	LOCATION OF WATER WELL: County: King	Fraction NE 1/4 NE 1/4 NE 1/4	Section Number 29	Township Number T 30 S	Range Number R 17 EW
---	--	---	-----------------------------	----------------------------------	--------------------------------

Distance and direction from nearest town or city street address of well if located within city?
13 S 5 W of Greensburg

2 WATER WELL OWNER: **John R Booth**
 RR#, St. Address, Box # : **P.O. Box 661**
 City, State, ZIP Code : **Collinsville, KS 67029**
 Board of Agriculture, Division of Water Resources
 Application Number: **20050038**

3 LOCATE WELL'S LOCATION WITH AN "X" IN SECTION BOX:

 4 DEPTH OF COMPLETED WELL **220** ft. ELEVATION:
 Depth(s) Groundwater Encountered 1 **110'** ft. 2 ft. 3 ft.
 WELL'S STATIC WATER LEVEL **110** ft. below land surface measured on mo/day/yr
 Pump test data: Well water was ft. after hours pumping gpm
 Est. Yield **3.5** gpm: Well water was ft. after hours pumping gpm
 WELL WATER TO BE USED AS:
 1 Domestic 3 Feedlot Oil field water supply 9 Dewatering 12 Other (Specify below)
 2 Irrigation 4 Industrial 7 Domestic (lawn & garden) 10 Monitoring well
 Was a chemical/bacteriological sample submitted to Department? Yes No; If yes, mo/day/yr sample was submitted
 Water Well Disinfected? Yes No

5 TYPE OF BLANK CASING USED:
 1 Steel 3 RMP (SR) 5 Wrought iron 8 Concrete tile CASING JOINTS: Glued Clamped
 PVC 4 ABS 6 Asbestos-Cement 9 Other (specify below) Welded
 7 Fiberglass Threaded
 Blank casing diameter **6"** in. to **180** ft., Dia in. to ft., Dia in. to ft.
 Casing height above land surface **24"** in., weight **S.D.R. 21** lbs./ft. Wall thickness or gauge No.
 TYPE OF SCREEN OR PERFORATION MATERIAL:
 1 Steel 3 Stainless Steel 5 Fiberglass PVC 10 Asbestos-Cement
 2 Brass 4 Galvanized Steel 6 Concrete tile 8 RMP (SR) 11 Other (Specify)
 9 ABS 12 None used (open hole)
 SCREEN OR PERFORATION OPENINGS ARE:
 1 Continuous slot Mill slot 5 Gauzed wrapped 8 Saw cut 11 None (open hole)
 2 Louvered shutter 4 Key punched 6 Wire wrapped 9 Drilled holes
 7 Torch cut 10 Other (specify)
 SCREEN-PERFORATED INTERVALS: From **180** ft. to **220** ft., From ft. to ft.
 From **220** ft. to ft., From ft. to ft.
 GRAVEL PACK INTERVALS: From **30** ft. to **220** ft., From ft. to ft.
 From ft. to ft., From ft. to ft.

6 GROUT MATERIAL: 1 Neat cement 2 Cement grout Bentonite 4 Other
 Grout Intervals: From **0** ft. to **30** ft., From ft. to ft., From ft. to ft.
 What is the nearest source of possible contamination:
 1 Septic tank 4 Lateral lines 7 Pit privy 10 Livestock pens 14 Abandoned water well
 2 Sewer lines 5 Cess pool 8 Sewage lagoon 11 Fuel storage 15 Oil well/Gas well
 3 Watertight sewer lines 6 Seepage pit 9 Feedyard 12 Fertilizer storage 16 Other (specify below)
 13 Insecticide storage **NA**
 Direction from well? How many feet?

FROM	TO	LITHOLOGIC LOG	FROM	TO	PLUGGING INTERVALS
0	8	Top soil + Sandy Clay			
8	16	Clitic			
16	32	Yellow Clay + Clitic			
32	164	Blue Shale Hard			
164	205	Sandstone + Shale Mix			
205	220	Red Brk			

7 CONTRACTOR'S OR LANDOWNER'S CERTIFICATION: This water well was (1) constructed, (2) reconstructed, or (3) plugged under my jurisdiction and was completed on (mo/day/year) **2-4-05** and this record is true to the best of my knowledge and belief. Kansas Water Well Contractor's Licence No **677**. This Water Well Record was completed on (mo/day/yr) **5-25-05** under the business name of **CLT Inc.** by (signature) **CT [Signature]**