USE TYPEWRITER OR BALL POINT PEN-PRESS FIRMLY, PRINT CLEARLY.

WATER WELL RECORD
KSA 82a-1201-1215

Kansas Department of Health and Environment-Division of Environment
(Water well Contractors)
Topeka, Kansas 66620

1. Location of well:	County: Kiowa	Fraction: 1/4 1/4 cnw 1/4	Section number: 16	Township number: T 30 S	Range number: R 18w E/W

2. Distance and direction from nearest town or city: 10 3/4 s
Street address of well location if in city: Greensburg, Ks.

3. Owner of well: Abercrombie Drlg. Inc
R.R. or street: R1 Great Bend, Ks.67530
City, state, zip code:

4. Locate with "X" in section below:

Sketch map:

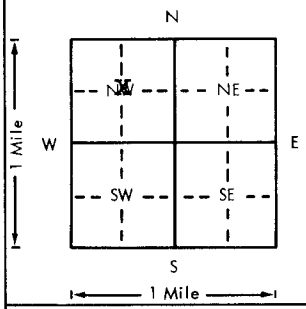

6. Bore hole dia. 8 in. Completion date
Well depth 225 ft. 5-8-78

7. __ Cable tool X Rotary __ Driven __ Dug
__ Hollow rod __ Jetted __ Bored __ Reverse rotary

8. Use: __ Domestic __ Public supply __ Industry
__ Irrigation __ Air conditioning __ Stock
__ Lawn X Oil field water __ Other

9. Casing: Material
Threaded ___ Welded ___
RMP ___ PVC X
Dia. 5 in. to 225 ft. depth
Dia. ___ in. to ___ ft. depth
Height: Above ~~XXXXX~~ Surface 12 in.
Weight 2.8 lbs./ft.
Wall Thickness: inches or gage No. sch 40

5. Type and color of material	From	To
Top Soil-Clay	0	60
Sand-Clay	60	175
Sand-Gravel	175	225

(Use a second sheet if needed)

10. Screen: Manufacturer's name Jetstream
Type pvc Dia. 5"
Slot/gauze 1/32" Length 40'
Set between 185 ft. and 225 ft.
ft. and ft.
Gravel pack? X Size range of material 1/8-3/4"

11. Static water level: mo./day/yr.
110 ft. below land surface Date 5-8-78

12. Pumping level below land surfaces:
ft. after hrs. pumping g.p.m.
ft. after hrs. pumping g.p.m.
Estimated maximum yield 60 g.p.m.

13. Water sample submitted: mo./day/yr.
__ Yes X No Date

14. Well head completion:
__ Pitless adapter 12 Inches above grade

15. Well grouted? X
With: __ Neat cement X Bentonite __ Concrete
Depth: From 0 ft. to 10 ft.

16. Nearest source of possible contamination:
ft. 65 Direction se Type oil test
Well disinfected upon completion? __ Yes X No

17. Pump: X Not installed
Manufacturer's name
Model number HP Volts
Length of drop pipe ft. capacity g.p.m.
Type:
__ Submersible __ Turbine
__ Jet __ Reciprocating
__ Centrifugal __ Other

T 30 R 18 (W) Sec 16 1/4 1/4 1/4 cnw

18. Elevation:

Topography:
__ Hill
__ Slope
X Upland
__ Valley

19. Remarks:

20. Water well contractor's certification:
This well was drilled under my jurisdiction and this report is true to the best of my knowledge and belief.
Business name ~~Kellys Waterwell Ser~~ License No. 186
Address R2 Great Bend, Ks.
Signed Kelly Price Date 10-1-79
Authorized representative

Forward the white, blue and pink copies to the Department of Health and Environment

Form WWC-5

MI-1023