


1 LOCATION OF WATER WELL: County: IOWA Fraction: NW 1/4 SW 1/4 SW 1/4 Section Number: 19 Township Number: T 30 S Range Number: R 18 EW

Distance and direction from nearest town or city street address of well if located within city?
2 W. 13 S, GREENSBURG Kansas

2 WATER WELL OWNER: Kane Investment Co
 RR#, St. Address, Box #: P.O. Box Board of Agriculture, Division of Water Resources
 City, State, ZIP Code: Bartlesville Okla Application Number:

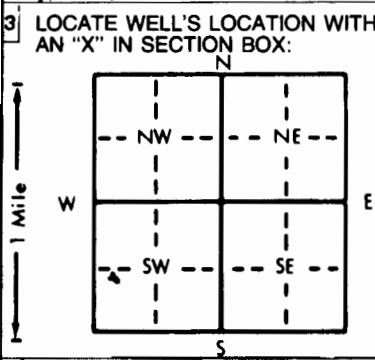

4 DEPTH OF COMPLETED WELL: 235 ft. ELEVATION: _____
 Depth(s) Groundwater Encountered: 1 ft. 2 ft. 3 ft.
 WELL'S STATIC WATER LEVEL: 140 ft. below land surface measured on 10-29-87 mo/day/yr
 Pump test data: Well water was 235 ft. after _____ hours pumping _____ gpm
 Est. Yield: 5 gpm; Well water was 235 ft. after _____ hours pumping _____ gpm
 Bore Hole Diameter: 8 3/4 in. to 235 ft., and _____ in. to _____ ft.
 WELL WATER TO BE USED AS:
 1 Domestic 2 Irrigation 3 Feedlot 4 Industrial
 5 Public water supply 6 Oil field water supply 7 Lawn and garden only
 8 Air conditioning 9 Dewatering 10 Observation well
 11 Injection well 12 Other (Specify below) _____
 Was a chemical/bacteriological sample submitted to Department? Yes _____ No X _____; If yes, mo/day/yr sample was submitted _____
 Water Well Disinfected? Yes X No _____

5 TYPE OF BLANK CASING USED:
 1 Steel 2 PVC 3 RMP (SR) 4 ABS
 5 Wrought iron 6 Asbestos-Cement 7 Fiberglass
 8 Concrete tile 9 Other (specify below) _____
 CASING JOINTS: Glued X Clamped _____
 Welded _____
 Threaded _____
 Blank casing diameter: 5 in. to 180 ft., Dia _____ in. to _____ ft., Dia _____ in. to _____ ft.
 Casing height above land surface: 12 in., weight _____ lbs./ft. Wall thickness or gauge No. SDR-26
 TYPE OF SCREEN OR PERFORATION MATERIAL:
 1 Steel 2 Brass 3 Stainless steel 4 Galvanized steel 5 Fiberglass 6 Concrete tile 7 PVC 8 RMP (SR) 9 ABS 10 Asbestos-cement 11 Other (specify) _____
 12 None used (open hole) _____
 SCREEN OR PERFORATION OPENINGS ARE:
 1 Continuous slot 2 Louvered shutter 3 Mill slot 4 Key punched 5 Gauzed wrapped 6 Wire wrapped 7 Torch cut 8 Saw cut 9 Drilled holes 10 Other (specify) _____
 11 None (open hole) _____
 SCREEN-PERFORATED INTERVALS: From 180 ft. to 235 ft., From _____ ft. to _____ ft.
 GRAVEL PACK INTERVALS: From 100 ft. to 235 ft., From _____ ft. to _____ ft.

6 GROUT MATERIAL: 1 Neat cement 2 Cement grout 3 Bentonite 4 Other _____
 Grout Intervals: From 4 ft. to 24 ft., From _____ ft. to _____ ft., From _____ ft. to _____ ft.
 What is the nearest source of possible contamination:
 1 Septic tank 2 Sewer lines 3 Watertight sewer lines 4 Lateral lines 5 Cess pool 6 Seepage pit 7 Pit privy 8 Sewage lagoon 9 Feedyard 10 Livestock pens 11 Fuel storage 12 Fertilizer storage 13 Insecticide storage 14 Abandoned water well 15 Oil well/Gas well 16 Other (specify below) _____
 Direction from well? N. How many feet? 75

FROM	TO	LITHOLOGIC LOG	FROM	TO	LITHOLOGIC LOG
0	1	Top Soil			
1	50	Tan Clay - Gyp Rock			
50	60	Sand with Clay Streaks			
60	100	Sandy Clay			
100	110	Tan Clay (Stuff)			
110	154	Blue Shale			
154	235	Red Bed			
120	140	Lost Lots of Circulation			
160	180	" "			
200	210	Brown Rock Streaks			

7 CONTRACTOR'S OR LANDOWNER'S CERTIFICATION: This water well was (1) constructed, (2) reconstructed, or (3) plugged under my jurisdiction and was completed on (mo/day/year) 10-29-87 and this record is true to the best of my knowledge and belief. Kansas Water Well Contractor's License No. 234 This Water Well Record was completed on (mo/day/yr) 11-27-87 under the business name of Carl Hays Water Well Serv by (signature) Carl Hays

INSTRUCTIONS: Use typewriter or ball point pen. PLEASE PRESS FIRMLY and PAINT clearly. Please fill in blanks, underline or circle the correct answers. Send top three copies to Kansas Department of Health and Environment, Bureau of Water Protection, Topeka, Kansas 66620-7320, Telephone: 913-862-9360. Send one to WATER WELL OWNER and retain one for your records.

OFFICE USE ONLY
T
R
EW
SEC.
1/4
1/4
1/4