


WATER WELL RECORD Form WWC-5 KSA 82a-1212

1 LOCATION OF WATER WELL: Fraction NW 1/4 NE 1/4 NE 1/4 Section Number 29 Township Number T 30 S Range Number R 19 W  
 COUNTY: KIOWA

Distance and direction from nearest town or city street address of well if located within city?  
 3.5 MILES EAST, 12.5 MILES SOUTH OF MILLINVILLE

2 WATER WELL OWNER: GLOBE OPERATING INC  
 RR#, St. Address, Box # : 1926 MAIN STREET Board of Agriculture, Division of Water Resources  
 City, State, ZIP code : GREAT BEND, KS 67530- Application Number: 20030040

3 LOCATE WELL'S LOCATION WITH AN "X" IN SECTION BOX:

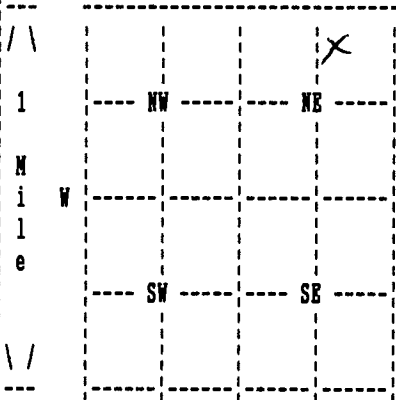

4 DEPTH OF COMPLETED WELL 200 ELEVATION: 0  
 Depth(s) Groundwater Encountered 1. 0 ft. 2. 0 ft. 3. 0 ft.

WELL'S STATIC WATER LEVEL 112 ft. below land surface measured on mo/day/yr 04/10/03  
 Pump testdata: Well water was 0 ft. after 0 hours pumping 0 gpm

Estimated Yield 0 gpm: Well water was 0 ft. after 0 hours pumping 0 gpm

Bore Hole Diameter 8.75 in. to 200 ft., and in. to 0 ft.

WELL WATER TO BE USED AS: OIL FIELD

Was a chemical/bacteriological sample submitted to department? No ;  
 If yes, mo/day/yr sample was submitted Water well disinfected? Yes

5 TYPE OF BLANK CASING USED: PVC CASING JOINTS: GLUED  
 Blank casing diameter 5 in. to 180 ft., Dia in. to 0 ft., Dia in. to 0 ft.  
 Casing height above land surface 12 in., weight 0 lbs/ft. Wall thickness or gauge No. 21  
 TYPE OF SCREEN OR PERFORATION MATERIAL: PVC  
 SCREEN OR PERFORATION OPENINGS ARE: SAW CUT

SCREEN PERFORATED INTERVALS: From 180 ft. to 200 ft., From 0 ft. to 0 ft.  
 From 0 ft. to 0 ft., From 0 ft. to 0 ft.  
 GRAVEL PACK INTERVALS: From 22 ft. to 200 ft., From 0 ft. to 0 ft.  
 From 0 ft. to 0 ft., From 0 ft. to 0 ft.

6 GROUT MATERIAL BENTONITE  
 Grout Intervals: From 1 ft. to 22 ft., From 0 ft. to 0 ft., From 0 ft. to 0 ft.

What is the nearest source of possible contamination: OIL/GAS WELL

Direction from well? SOUTHWEST How many feet? 50

FROM	TO	LITHOLOGIC LOG	FROM	TO	PLUGGING INTERVALS
0	65	TAN CLAY			
65	88	SAND AND GRAVEL			
88	106	TAN CLAY			
106	138	SAND AND GRAVEL			
138	164	TAN CLAY			
164	190	SAND AND GRAVEL			
190	191	TAN CLAY			
191	200	SAND AND GRAVEL			

7 CONTRACTOR'S OR LANDOWNER'S CERTIFICATION: This water well was Constructed under my jurisdiction and was completed on (mo/day/year) 04/10/03 and this record is true to the best of my knowledge and belief. Kansas Water Well Contractor's License No. 653 This Water Well Record was completed on (mo/day/yr) 06/06/03 under the business name of DAN HAYSE WATER WELL SVC. by (signature) Dan Hayse