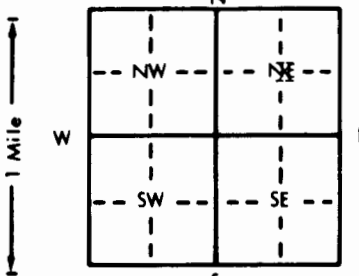


1 LOCATION OF WATER WELL: Fraction Near Center Section Number 34 Township Number T 30 S Range Number R 19 EW
 County: Kiowa $\frac{1}{4}$ $\frac{1}{4}$ NE $\frac{1}{4}$

Distance and direction from nearest town or city street address of well if located within city? From Junction 54 & 183 west of Greensburg, 15 1/2 Miles south (County Line), 3 Miles west, 3,945 Ft. North & 1,230 Ft. West.

2 WATER WELL OWNER: Harold McKinney
 RR#, St. Address, Box # : HCR 72
 City, State, ZIP Code : Coldwater, Kansas 67029
 Board of Agriculture, Division of Water Resources
 Application Number: 40,319

3 LOCATE WELL'S LOCATION WITH AN "X" IN SECTION BOX:

 4 DEPTH OF COMPLETED WELL: 180 ft. ELEVATION:
 Depth(s) Groundwater Encountered 1. ft. 2. ft. 3. ft.
 WELL'S STATIC WATER LEVEL .79 ft. below land surface measured on mo/day/yr 12-9-93
 Pump test data: Well water was ft. after hours pumping gpm
 Est. Yield gpm: Well water was ft. after hours pumping gpm
 Bore Hole Diameter .30 in. to 180 ft., and in. to ft.
 WELL WATER TO BE USED AS: 5 Public water supply 8 Air conditioning 11 Injection well
 1 Domestic 3 Feedlot 6 Oil field water supply 9 Dewatering 12 Other (Specify below)
 ② Irrigation 4 Industrial 7 Lawn and garden only 10 Monitoring well
 Was a chemical/bacteriological sample submitted to Department? Yes.....No...X.....; If yes, mo/day/yr sample was submitted
 Water Well Disinfected? Yes No X

5 TYPE OF BLANK CASING USED:
 ① Steel 3 RMP (SR) 5 Wrought iron 8 Concrete tile CASING JOINTS: Glued Clamped
 2 PVC 4 ABS 6 Asbestos-Cement 9 Other (specify below) Welded X
 7 Fiberglass Threaded.....
 Blank casing diameter 18 in. to 110 ft., Dia in. to ft., Dia in. to ft.
 Casing height above land surface 12 in., weight 47.39 lbs./ft. Wall thickness or gauge No. 250
 TYPE OF SCREEN OR PERFORATION MATERIAL:
 ① Steel 3 Stainless steel 5 Fiberglass 7 PVC 10 Asbestos-cement
 2 Brass 4 Galvanized steel 6 Concrete tile 9 ABS 11 Other (specify)
 12 None used (open hole)
 SCREEN OR PERFORATION OPENINGS ARE:
 1 Continuous slot ③ Mill slot 5 Gauzed wrapped 8 Saw cut 11 None (open hole)
 2 Louvered shutter 4 Key punched ⑥ Wire wrapped 9 Drilled holes
 7 Torch cut 10 Other (specify)
 SCREEN-PERFORATED INTERVALS: From 110 ft. to 180 ft., From ft. to ft.
 From ft. to ft., From ft. to ft.
 GRAVEL PACK INTERVALS: From 20 ft. to 180 ft., From ft. to ft.
 From ft. to ft., From ft. to ft.

6 GROUT MATERIAL: 1 Neat cement ② Cement grout 3 Bentonite 4 Other
 Grout intervals: From 0 ft. to 20 ft., From ft. to ft., From ft. to ft.
 What is the nearest source of possible contamination:
 1 Septic tank 4 Lateral lines 7 Pit privy 10 Livestock pens 14 Abandoned water well
 2 Sewer lines 5 Cess pool 8 Sewage lagoon 11 Fuel storage 15 Oil well/Gas well
 3 Watertight sewer lines 6 Seepage pit 9 Feedyard 12 Fertilizer storage 16 Other (specify below)
 13 Insecticide storage NA
 Direction from well? How many feet?

FROM	TO	LITHOLOGIC LOG	FROM	TO	PLUGGING INTERVALS
		See attached log			

7 CONTRACTOR'S OR LANDOWNER'S CERTIFICATION: This water well was ① constructed, (2) reconstructed, or (3) plugged under my jurisdiction and was completed on (mo/day/year) 12-29-93 and this record is true to the best of my knowledge and belief. Kansas Water Well Contractor's License No. 208 This Water Well Record was completed on (mo/day/yr) 1-4-94 under the business name of Minter-Wilson Drilling Co., Inc. by (signature) Nora Keller

INSTRUCTIONS: Use typewriter or ball point pen. PLEASE PRESS FIRMLY and PRINT clearly. Please fill in blanks, underline or circle the correct answers. Send top three copies to Kansas Department of Health and Environment, Bureau of Water, Topeka, Kansas 66620-0001. Telephone: 913-296-5545. Send one to WATER WELL OWNER and retain one for your records.

OFFICE USE ONLY
T
R
EW
SEC.
1/4
1/4
1/4

WILSON DRILLING CO.
INCORPORATED

Irrigation
and Domestic
Water Systems
Complete Installation
and Repairing

Phone 276-8269 • P.O. Box A • GARDEN CITY, KANSAS 67846

Dennis & Harold McKinney
Kiowa County
2/20/91

Location: NE $\frac{1}{4}$ 34-30-19 Greensburg JCT 183 & 54 South
— 16 miles, 3 miles West, $\frac{3}{4}$ North, $\frac{1}{2}$ West

Static Water Level - 82'

Test #1

0	3	Top soil
3	52 ⁰¹	Brown clay
52	69 ²⁸	Brown clay brown white rock mixed
69	74 ⁰⁸	Fine to medium sand hard
74	81 ⁰⁷	Fine to medium sand hard 15% clay
81	98 ¹⁷	Fine to medium sand gravel loose
98	119 ⁰²	Fine to medium sand
119	127 ⁰⁸	Fine to medium sand 10% clay tight
127	140 ¹⁷	Fine to medium sand gravel loose
140	163 ⁰⁴	Brown sandy clay
163	170 ⁰⁸	Fine to medium sand 10% clay loose
170	185 ¹⁹	Red bed