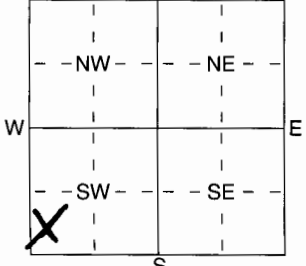


1 LOCATION OF WATER WELL: Fraction SW 1/4 SW 1/4 Section Number 24 Township Number T 30 S Range Number R 19 E  
 County: Biowag

Distance and direction from nearest town or city street address of well if located within city?  
105 mi. N of Greensburg - 2 mi. West 1/2 South 1/4 East

2 WATER WELL OWNER: David Allen  
 RR#, St. Address, Box # : RR 2  
 City, State, ZIP Code : Greensburg KS  
 Board of Agriculture, Division of Water Resources  
 Application Number:

3 LOCATE WELL'S LOCATION WITH AN "X" IN SECTION BOX:  
  
 4 DEPTH OF COMPLETED WELL 115 ft. ELEVATION:  
 Depth(s) Groundwater Encountered 115 ft. 2 ..... ft. 3 12-3-06 ft.  
 WELL'S STATIC WATER LEVEL 115 ft. below land surface measured on mo/day/yr  
 Pump test data: Well water was ..... ft. after ..... hours pumping ..... gpm  
 Est. Yield ..... gpm: Well water was ..... ft. after ..... hours pumping ..... gpm  
 WELL WATER TO BE USED AS:  
 1 Domestic 3 Feedlot 6 Oil field water supply 9 Dewatering 12 Other (Specify below)  
 2 Irrigation 4 Industrial 7 Domestic (lawn & garden) 10 Monitoring well Case 2011  
 5 Public water supply 8 Air conditioning 11 Injection well  
 Was a chemical/bacteriological sample submitted to Department? Yes ..... No ..... If yes, mo/day/yr sample was submitted  
 Water Well Disinfected? Yes X No

5 TYPE OF BLANK CASING USED:  
 1 Steel 3 RMP (SR) 5 Wrought iron 8 Concrete tile CASING JOINTS: Glued X Clamped .....  
 2 PVC 4 ABS 6 Asbestos-Cement 9 Other (specify below) Welded .....  
 7 Fiberglass Threaded .....  
 Blank casing diameter 5 in. to 115 ft., Dia 160 in. to ..... ft., Dia ..... in. to ..... ft.  
 Casing height above land surface 12 in., weight ..... lbs./ft. Wall thickness or guage No. ....  
 TYPE OF SCREEN OR PERFORATION MATERIAL:  
 1 Steel 3 Stainless Steel 5 Fiberglass 8 RMP (SR) 10 Asbestos-Cement  
 2 Brass 4 Galvanized Steel 6 Concrete tile 9 ABS 11 Other (Specify) .....  
 12 None used (open hole)  
 SCREEN OR PERFORATION OPENINGS ARE:  
 1 Continuous slot 3 Mill slot 5 Gauzed wrapped 8 Saw cut 11 None (open hole)  
 2 Louvered shutter 4 Key punched 6 Wire wrapped 9 Drilled holes  
 7 Torch cut 10 Other (specify) ..... ft.  
 SCREEN-PERFORATED INTERVALS: From 115 ft. to 200 ft., From ..... ft. to ..... ft.  
 GRAVEL PACK INTERVALS: From 115 ft. to 50 ft., From 40 ft. to 20 ft.  
 From ..... ft. to ..... ft., From ..... ft. to ..... ft.

6 GROUT MATERIAL: 1 Neat cement 2 Cement grout X Bentonite 4 Other .....  
 Grout Intervals: From 50 ft. to 40 ft., From 20 ft. to 0 ft., From ..... ft. to ..... ft.  
 What is the nearest source of possible contamination:  
 1 Septic tank 4 Lateral lines 7 Pit privy 10 Livestock pens 14 Abandoned water well  
 2 Sewer lines 5 Cess pool 8 Sewage lagoon 11 Fuel storage 15 Oil well/Gas well  
 3 Watertight sewer lines 6 Seepage pit 9 Feedyard 12 Fertilizer storage 16 Other (specify below)  
 13 Insecticide storage  
 Direction from well? NE How many feet? 500 ft

FROM	TO	LITHOLOGIC LOG	FROM	TO	PLUGGING INTERVALS
0	15	TAN clay			
15	28	Brown Clay			
28	35	Fine Sand - TAN			
35	50	TAN Clay			
50	80	Fine Sand - TAN			
80	100	TAN Clay			
100	110	Fine Sand - TAN			
110	115	TAN Clay			

7 CONTRACTOR'S OR LANDOWNER'S CERTIFICATION: This water well was X constructed, (2) reconstructed, or (3) plugged under my jurisdiction and was completed on (mo/day/year) 12-3-06 and this record is true to the best of my knowledge and belief. Kansas Water Well Contractor's Licence No 672 This Water Well Record was completed on (mo/day/yr) 12-16-06 under the business name of Clawds Water Well by (signature) [Signature]