

WATER WELL RECORD

Form WWC-5


Division of Water Resources App. No.

1 LOCATION OF WATER WELL: County: Kiowa, Fraction: 1/4 NW 1/4 NE 1/4 NW 1/4, Section Number: 22, Township No.: T 30 S, Range Number: R 19 E W

Street/Rural Address of Well Location; if unknown, distance & direction from nearest town or intersection: Approximately 12 miles south and 5 miles west of Greensburg.

2 WATER WELL OWNER: John Rose, RR#, Street Address, Box #: 22327 13th Ave, City, State, ZIP Code: Mullinville, KS 67109

Global Positioning System (GPS) information: Latitude: 37.424448, Longitude: -99.387096, Elevation: unknown, Datum: NAD 83, Collection Method: WAAS, GPS unit (Make/Model):

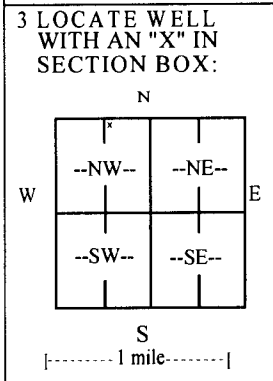

4 DEPTH OF COMPLETED WELL: 192 ft. Depth(s) Groundwater Encountered (1) 111.60 ft. WELL'S STATIC WATER LEVEL 111.60 ft. below land surface measured on mo/day/yr 07/13/11. Pump test data: Well water was not checked ft. after hours pumping gpm. EST. YIELD gpm. Well water was ft. after hours pumping gpm. Bore Hole Diameter 9 in. to 195 ft., and in. to ft. WELL WATER TO BE USED AS: Public water supply, Geothermal, Injection well, Domestic, Feedlot, Oil field water supply, Dewatering, Other (Specify below) Stock Well, Irrigation, Industrial, Domestic-lawn & garden, Monitoring well. Was a chemical/bacteriological sample submitted to Department? Yes No. If yes, mo/day/yr sample was submitted. Water well disinfected? Yes No.

5 TYPE OF CASING USED: Steel PVC Other. CASING JOINTS: Glued Clamped Welded Threaded. Casing diameter 5 in. to 135 ft., Diameter 5 in. to 190 ft., Diameter in. to ft. Casing height above land surface 24 in., Weight 2.37 lbs./ft., Wall thickness or gauge No. 214. TYPE OF SCREEN OR PERFORATION MATERIAL: Steel Stainless Steel PVC Other (Specify). SCREEN OR PERFORATION OPENINGS ARE: Continuous slot Mill slot Gauze wrapped Torch cut Drilled holes None (open hole), Louvered shutter Key punched Wire wrapped Saw cut Other (specify). SCREEN-PERFORATED INTERVALS: From 135 ft. to 165 ft., From ft. to ft. GRAVEL PACK INTERVALS: From 22 ft. to 195 ft., From ft. to ft.

6 GROUT MATERIAL: Neat cement Cement grout Bentonite Other. Grout intervals: From ft. to ft., From 0 ft. to 22 ft., From ft. to ft. What is the nearest source of possible contamination: Septic tank Lateral lines Pit privy Livestock pens Insecticide storage Other (specify below), Sewer lines Cesspool Sewage lagoon Fuel storage Abandoned water well None Known, Watertight sewer lines Seepage pit Feedyard Fertilizer storage Oil well/gas well. Direction from well Distance from well.

Table with columns FROM, TO, LITHOLOGIC LOG, FROM, TO, LITHO. LOG (cont.) or PLUGGING INTERVALS. Rows include Topsoil, Clay, brown, Clay, gray, Clay, tan, white, brown, caliche, Sand, fine - coarse, Clay, white, caliche, Clay, white, with sand streaks, Sand, gravel, fine - medium, Clay, white, brown, caliche.

7 CONTRACTOR'S OR LANDOWNER'S CERTIFICATION: This water well was constructed, reconstructed, or plugged under my jurisdiction and was completed on (mo/day/year) 07/13/11 and this record is true to the best of my knowledge and belief. Kansas Water Well Contractor's License No. 185 This Water Well Record was completed on (mo/day/year) 07/22/11 under the business name of Clarke Well & Equipment, Inc. by (signature)

INSTRUCTIONS: Use typewriter or ball point pen. PLEASE PRESS FIRMLY and PRINT clearly. Please fill in blanks and check the correct answers. Send three copies (white, blue, pink) to Kansas Department of Health and Environment, Bureau of Water, Geology Section, 1000 SW Jackson St., Suite 420, Topeka, Kansas 66612-1367. Telephone 785-296-5522. Send one copy to WATER WELL OWNER and retain one for your records. Include fee of \$5.00 for each constructed well. Visit us at http://www.kdheks.gov/waterwell/index.html.