


1 LOCATION OF WATER WELL: Sumner	FRACTION NE 1/4 NW 1/4 NE 1/4	Section Number 18	Township Number T 30 S	Range Number R 2W E/W
--	---	-----------------------------	----------------------------------	---------------------------------

Distance and direction from nearest town or city street address of well if located within city?
3.5 m. N. & 3.7 m. E. of Conway Springs, Kansas, S. side of road

2 WATER WELL OWNER: ROWE, Hank and Linda RR#, ST. ADDRESS, BOX #: R.R. #1, Box 37 CITY, STATE, ZIP CODE: Conway Springs, Kansas	Board of Agriculture, Division of Water Resource Application Number:
--	---

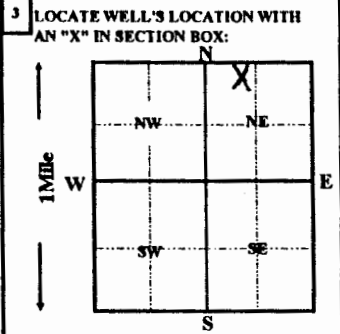

4 DEPTH OF COMPLETED WELL 60 ft. ELEVATION: Depth(s) groundwater Encountered 1 ft. 2 ft. 3 ft.	WELL'S STATIC WATER LEVEL 22 FT. BELOW LAND SURFACE MEASURED ON 09/07/1995 Pump test data: Well water was _____ ft. after _____ hours pumping _____ gpm
Est. Yield _____ gpm: Well water was _____ ft. after _____ hours pumping _____ gpm	Bore Hole Diameter unknown in. to _____ ft. and _____ in. to _____ ft.
WELL WATER TO BE USED AS: 5 Public water supply 8 Air conditioning 11 Injection well 1 Domestic 3 Feedlot 6 Oil field water supply 9 Dewatering 12 Other (Specify below) 2 Irrigation 4 Industrial 7 Lawn and garden only 10 Monitoring well	Was a chemical/bacteriological sample submitted to Department? Yes _____ No X ; If yes, mo/day/yr sample was submitted _____
Water Well Disinfected? Yes X No _____	

5 TYPE OF CASING USED: 1 Steel 3 RMP (SR) 2 PVC 4 ABS Blank casing Diameter 6 in. to _____ ft., Dia _____ in. to _____ ft. Casing height below land surface 36 in., weight _____ lbs. / ft.	3 Wrought iron 6 Asbestos-Cement 7 Fiberglass 8 Concrete tile 9 Other (Specify below) galvanized	CASING JOINTS: Glued Clamped Welded Threaded X
TYPE OF SCREEN OR PERFORATION MATERIAL: 1 Steel 3 Stainless Steel 2 Brass 4 Galvanized steel	5 Fiberglass 6 Concrete tile	7 PVC 10 Asbestos-cement 8 RMP (SR) 11 other (specify) N/A 9 ABS 12 None used (open hole)
SCREEN OR PERFORATION OPENING ARE: 1 Continuous slot 3 Mill slot 2 Louvered shutter 4 Key punched	5 Gauzed wrapped 6 Wire wrapped 7 Torch cut	8 Saw cut 11 None (open hole) 9 Drilled holes 10 Other (specify) N/A
SCREEN-PERFORATION INTERVALS: from _____ ft. to _____ ft.		
GRAVEL PACK INTERVALS: from _____ ft. to _____ ft.		

6 GROUT MATERIAL: 1 Neat cement 2 Cement grout 3 Bentonite 4 Other bentonite hole plug	Grout Intervals: From _____ ft. to _____ ft. From _____ ft. to _____ ft.
What is the nearest source of possible contamination: 1 Septic tank 4 Lateral lines 7 Pit privy 2 Sewer lines 5 Cess pool 8 Sewage lagoon 3 Watertight sewer lines 6 Seepage pit 9 Feedyard	10 Livestock pens 14 Abandon water well 11 Fuel storage 15 Oil well/Gas well 12 Fertilizer storage 16 Other (specify below) 13 Insecticide storage unknown
Direction from well? _____	How many feet? _____

FROM	TO	LITHOLOGIC LOG	FROM	TO	PLUGGING INTERVALS
			0	6	cement grout
			6	30	bentonite hole plug
			30	60	chlorinated sand and gravel

7 CONTRACTOR'S OR LANDOWNER'S CERTIFICATION: This water well was (1) constructed, (2) reconstructed, or (3) plugged under my jurisdiction and was completed on (mo/day/year) 09/07/1995 and this record is true to the best of my knowledge and belief. Kansas Water Well Contractor's License No. 236 This Water Well Record was completed on (mo/day/yr) 09/11/95 Under the business name of Harp Well & Pump Service, Inc. by (signature) <i>Jane Frederick</i>
