


WATER WELL RECORD Form WWC-5 KSA 82a-1212

1 LOCATION OF WATER WELL: COUNTY: CLARK Fraction NW 1/4 SE 1/4 SW 1/4 Section Number 14 Township Number T 30 S Range Number R 21 W

Distance and direction from nearest town or city street address of well if located within city? 7 MILES SOUTH, 2 MILES EAST, 2 MILES SOUTH OF BUCKLIN

2 WATER WELL OWNER: MCCOLM, ROBERT RR#, St. Address, Box #: PO BOX City, State, ZIP code: BUCKLIN, KS 67834- Board of Agriculture, Division of Water Resources Application Number:

3 LOCATE WELL'S LOCATION WITH AN "X" IN SECTION BOX:

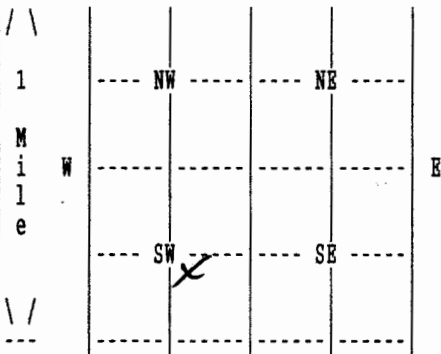

4 DEPTH OF COMPLETED WELL 171 ELEVATION: 0 Depth(s) Groundwater Encountered 1. 0 ft. 2. 0 ft. 3. 0 ft.

WELL'S STATIC WATER LEVEL 44 ft. below land surface measured on mo/day/yr 09/01/04 Pump test data: Well water was 0 ft. after 0 hours pumping 0 gpm

Estimated Yield 0 gpm: Well water was 0 ft. after 0 hours pumping 0 gpm

Bore Hole Diameter 6 in. to 171 ft., and in. to 0 ft.

WELL WATER TO BE USED AS: MONITORING

Was a chemical/bacteriological sample submitted to department? No; If yes, mo/day/yr sample was submitted Water well disinfected? Yes

5 TYPE OF BLANK CASING USED: PVC CASING JOINTS: GLUED Blank casing diameter 2 in. to 91 ft., Dia in. to 0 ft., Dia in. to 0 ft. Casing height above land surface 12 in., weight 0 lbs/ft. Wall thickness or gauge No. 40 TYPE OF SCREEN OR PERFORATION MATERIAL: PVC SCREEN OR PERFORATION OPENINGS ARE: SAW CUT

SCREEN PERFORATED INTERVALS: From 91 ft. to 171 ft., From 0 ft. to 0 ft. From 0 ft. to 0 ft., From 0 ft. to 0 ft. GRAVEL PACK INTERVALS: From 45 ft. to 171 ft., From 0 ft. to 0 ft. From 0 ft. to 0 ft., From 0 ft. to 0 ft.

6 GROUT MATERIAL BENTONITE Grout Intervals: From 0 ft. to 45 ft., From 0 ft. to 0 ft., From 0 ft. to 0 ft. What is the nearest source of possible contamination: OIL/GAS WELL Direction from well? EAST How many feet? 900

Table with columns: FROM, TO, LITHOLOGIC LOG, FROM, TO, PLUGGING INTERVALS. Rows list geological layers from 0 to 76 feet depth: BROWN CLAY, TAN CLAY, SAND AND GRAVEL, WHITE CLAY, WHITE ROCK, SAND AND GRAVEL.

7 CONTRACTOR'S OR LANDOWNER'S CERTIFICATION: This water well was Constructed under my jurisdiction and was completed on (mo/day/year) 09/01/04 and this record is true to the best of my knowledge and belief. Kansas Water Well Contractor's License No. 653 This Water Well Record was completed on (mo/day/yr) 10/15/04 under the business name of DAN HAYSE WATER WELL SERV by (signature) Dan Hayse

(Continued)

WATER WELL RECORD Form WWC-5 KSA 82a-1212

1 LOCATION OF WATER WELL: COUNTY: CLARK	Fraction NW 1/4 SE 1/4 SW 1/4	Section Number 14	Township Number T 30 S	Range Number R 21 W
--	----------------------------------	----------------------	---------------------------	------------------------

2 WATER WELL OWNER: MCCOLM, ROBERT
 RR#, St. Address, Box #: PO BOX
 City, State, ZIP code: BUCKLIN, KS 67834-
 Board of Agriculture, Division of Water Resources
 Application Number:

FROM	TO	LITHOLOGIC LOG
99	121	TAN CLAY
121	171	SAND AND GRAVEL
171	172	GRAY SHALE

7 CONTRACTOR'S OR LANDOWNER'S CERTIFICATION: This water well was Constructed under my jurisdiction and was completed on (mo/day/year) 09/01/04 and this record is true to the best of my knowledge and belief. Kansas Water Well Contractor's License No. 653 This Water Well Record was completed on (mo/day/yr) 10/15/04 under the business name of DAN HAYSE WATER WELL SERV by (signature)