


WATER WELL RECORD Form WWC-5 KSA 82a-1212

1 LOCATION OF WATER WELL: Fraction Section Number Township Number Range Number
COUNTY: CLARK SE 1/4 SW 1/4 SW 1/4 14 T 30 S R 21 W

Distance and direction from nearest town or city street address of well if located within city?
7 MILES SOUTH, 2 MILES EAST, 2 MILES SOUTH OF BUCKLIN

2 WATER WELL OWNER: MCCOLM, ROBERT
RR#, St. Address, Box #: PO BOX Board of Agriculture, Division of Water Resources
City, State, ZIP code: BUCKLIN, KS 67834- Application Number:

3 LOCATE WELL'S LOCATION WITH AN "X" IN SECTION BOX:

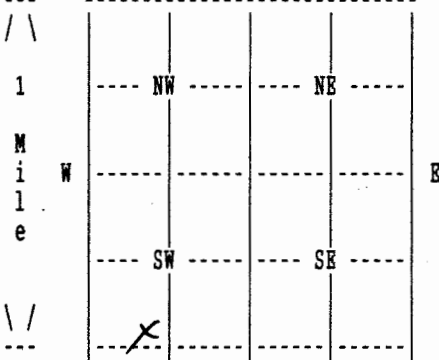

4 DEPTH OF COMPLETED WELL 146 ELEVATION: 0
Depth(s) Groundwater Encountered 1. 0 ft. 2. 0 ft. 3. 0 ft.

WELL'S STATIC WATER LEVEL 34 ft. below land surface measured on mo/day/yr 09/04/04
Pump test data: Well water was 0 ft. after 0 hours pumping 0 gpm

Estimated Yield 0 gpm: Well water was 0 ft. after 0 hours pumping 0 gpm

Bore Hole Diameter 8.75 in. to 146 ft., and in. to 0 ft.

WELL WATER TO BE USED AS: LIVESTOCK

Was a chemical/bacteriological sample submitted to department? No ;
If yes, mo/day/yr sample was submitted Water well disinfected? Yes

5 TYPE OF BLANK CASING USED: PVC CASING JOINTS: GLUED
Blank casing diameter 5 in. to 126 ft., Dia in. to 0 ft., Dia in. to 0 ft.
Casing height above land surface 12 in., weight 0 lbs/ft. Wall thickness or gauge No. 26
TYPE OF SCREEN OR PERFORATION MATERIAL: PVC
SCREEN OR PERFORATION OPENINGS ARE: SAW CUT

SCREEN PERFORATED INTERVALS: From 126 ft. to 146 ft., From 0 ft. to 0 ft.
From 0 ft. to 0 ft., From 0 ft. to 0 ft.
GRAVEL PACK INTERVALS: From 30 ft. to 146 ft., From 0 ft. to 0 ft.
From 0 ft. to 0 ft., From 0 ft. to 0 ft.

6 GROUT MATERIAL BENTONITE
Grout Intervals: From 4 ft. to 30 ft., From 0 ft. to 0 ft., From 0 ft. to 0 ft.
What is the nearest source of possible contamination: OIL/GAS WELL
Direction from well? EAST How many feet? 1600

FROM	TO	LITHOLOGIC LOG	FROM	TO	PLUGGING INTERVALS
0	2	BROWN CLAY			
2	19	TAN CLAY			
19	27	SAND AND GRAVEL			
27	34	TAN CLAY			
34	56	SAND AND GRAVEL			
56	62	TAN CLAY			
62	92	SAND AND GRAVEL			
92	100	TAN CLAY			
100	108	SAND AND GRAVEL			
108	110	TAN CLAY			

7 CONTRACTOR'S OR LANDOWNER'S CERTIFICATION: This water well was Constructed under my jurisdiction and was completed on (mo/day/year) 09/04/04 and this record is true to the best of my knowledge and belief. Kansas Water Well Contractor's License No. 653 This Water Well Record was completed on (mo/day/yr) 10/15/04 under the business name of DAN HAYSE WATER WELL SERV by (signature) Dan Hayse

(Continued)

WATER WELL RECORD Form WWC-5 KSA 82a-1212

216

1 LOCATION OF WATER WELL: COUNTY: CLARK	Fraction SE 1/4 SW 1/4 SW 1/4	Section Number 14	Township Number T 30 S	Range Number R 21 W
--	----------------------------------	----------------------	---------------------------	------------------------

2 WATER WELL OWNER: MCCOLM, ROBERT	Board of Agriculture, Division of Water Resources
RR#, St. Address, Box #: PO BOX	Application Number:
City, State, ZIP code: BUCKLIN, KS 67834-	

FROM	TO	LITHOLOGIC LOG
110	124	SAND AND GRAVEL
124	138	TAN CLAY
138	146	SAND AND GRAVEL
146	147	GRAY SHALE

7 CONTRACTOR'S OR LANDOWNER'S CERTIFICATION: This water well was Constructed under my jurisdiction and was completed on (mo/day/year) 09/04/04 and this record is true to the best of my knowledge and belief. Kansas Water Well Contractor's License No. 653 This Water Well Record was completed on (mo/day/yr) 10/15/04 under the business name of DAN HAYSE WATER WELL SERV by (signature)