

WATER WELL RECORD Form WWC-5

Original Record Correction Change in Well Use


Division of Water Resources App. No.

20180293

Well ID

1 LOCATION OF WATER WELL: Fraction $\frac{1}{4}$ SE $\frac{1}{4}$ NE $\frac{1}{4}$ SW $\frac{1}{4}$ Section Number 3 Township Number T 30 S Range Number R 21 E W
County: Clark

2 WELL OWNER: Last Name: First: Street or Rural Address where well is located (if unknown, distance and direction from nearest town or intersection): If at owner's address, check here:
Business: Mull Drilling Co Inc Address: 1700 N Waterfront Pkwy Bldg 1200 5 3/4 South, 1 1/4 East of Bucklin
Address: City: Wichita State: KS ZIP: 67206

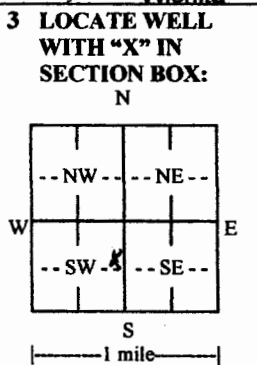

4 DEPTH OF COMPLETED WELL:198..... ft.
Depth(s) Groundwater Encountered: 1) ft.
2) ft. 3) ft., or 4) Dry Well
WELL'S STATIC WATER LEVEL:91..... ft.
 below land surface, measured on (mo-day-yr)12-3-18.....
 above land surface, measured on (mo-day-yr).....
Pump test data: Well water was ft.
after hours pumping gpm
Well water was ft.
after hours pumping gpm
Estimated Yield:gpm
Bore Hole Diameter:10..... in. to198..... ft. and
..... in. to ft.

5 Latitude:37.45850.....(decimal degrees)
Longitude:99.60377.....(decimal degrees)
Horizontal Datum: WGS 84 NAD 83 NAD 27
Source for Latitude/Longitude:
 GPS (unit make/model:)
(WAAS enabled? Yes No)
 Land Survey Topographic Map
 Online Mapper:

6 Elevation:ft. Ground Level TOC
Source: Land Survey GPS Topographic Map
 Other

7 WELL WATER TO BE USED AS:

1. Domestic: Household Lawn & Garden Livestock
2. Irrigation
3. Feedlot
4. Industrial

5. Public Water Supply: well ID

6. Dewatering: how many wells?

7. Aquifer Recharge: well ID

8. Monitoring: well ID

9. Environmental Remediation: well ID

Air Sparge Soil Vapor Extraction
 Recovery Injection

10. Oil Field Water Supply: leaseHaller #1-3.....

11. Test Hole: well ID

12. Geothermal: how many bores?

a) Closed Loop Horizontal Vertical
b) Open Loop Surface Discharge Inj. of Water

13. Other (specify):

Was a chemical/bacteriological sample submitted to KDHE? Yes No If yes, date sample was submitted:
Water well disinfected? Yes No

8 TYPE OF CASING USED: Steel PVC Other CASING JOINTS: Glued Clamped Welded Threaded
Casing diameter5..... in. to198..... ft., Diameter in. to ft., Diameter in. to ft.
Casing height above land surface18..... in. WeightSDR-26..... lbs./ft. Wall thickness or gauge No.

TYPE OF SCREEN OR PERFORATION MATERIAL:
 Steel Stainless Steel Fiberglass PVC Other (Specify)
 Brass Galvanized Steel Concrete tile None used (open hole)

SCREEN OR PERFORATION OPENINGS ARE:
 Continuous Slot Mill Slot Gauze Wrapped Torch Cut Drilled Holes Other (Specify)
 Louvered Shutter Key Punched Wire Wrapped Saw Cut None (Open Hole)

SCREEN-PERFORATED INTERVALS: From198..... ft. to155..... ft., From ft. to ft., From ft. to ft.
GRAVEL PACK INTERVALS: From198..... ft. to20..... ft., From ft. to ft., From ft. to ft.

9 GROUT MATERIAL: Neat cement Cement grout Bentonite Other
Grout Intervals: From ft. to ft., From20..... ft. to0..... ft., From ft. to ft.

Nearest source of possible contamination:
 Septic Tank Lateral Lines Pit Privy Livestock Pens Insecticide Storage
 Sewer Lines Cess Pool Sewage Lagoon Fuel Storage Abandoned Water Well
 Watertight Sewer Lines Seepage Pit Feedyard Fertilizer Storage Oil Well/Gas Well
 Other (Specify)None.....
Direction from well? Distance from well? ft.

10 FROM	TO	LITHOLOGIC LOG	FROM	TO	LITHO. LOG (cont.) or PLUGGING INTERVALS
0	3	Top soil	195	198	Gray shale
3	40	Sandy tan clay			
40	73	Tan clay w/ caliche			
73	85	Gravel- small tight			
85	90	Tan clay			
90	115	Small gravel w/ clay			
115	125	Cemented sand			Notes:
125	131	Tan clay			
131	195	Gravel- small med w/ clay streaks			

11 CONTRACTOR'S OR LANDOWNER'S CERTIFICATION: This water well was constructed, reconstructed, or plugged under my jurisdiction and was completed on (mo-day-year)12-3-18..... and this record is true to the best of my knowledge and belief.
Kansas Water Well Contractor's License No.134..... This Water Well Record was completed on (mo-day-year)12-31-18.....
under the business name ofRosencrantz- Bemis Ent Inc..... Signature*[Signature]*.....