USE TYPEWRITER OR BALL POINT PEN-PRESS FIRMLY, PRINT CLEARLY.

TURKEY CREEK

WATER WELL RECORD
KSA 82a-1201-1215

Kansas Department of Health and Environment-Division of Environment
(Water well Contractors)
Topeka, Kansas 66620

TB (center)

1. Location of well:	County	Fraction	Section number	Township number	Range number
	Clark	1/4 1/4 cnw 1/4	11	T 30 S	R 21W E/W

2. Distance and direction from nearest town or city: 7s 3e
Street address of well location if in city: Bucklin, Ks.

3. Owner of well: Red Tiger Drlg Co.
R.R. or street: 1720 Ks St Bk Bldg
City, state, zip code: Wichita, Ks. 67202

4. Locate with "X" in section below:

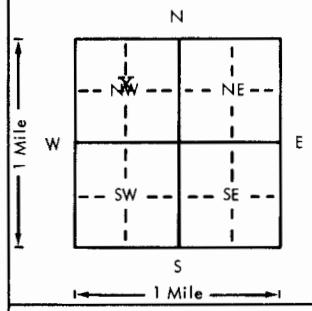

Sketch map:

6. Bore hole dia. 8 in. Completion date ____
Well depth 192 ft. 3-22-78

7. __ Cable tool X Rotary __ Driven __ Dug
__ Hollow rod __ Jetted __ Bored __ Reverse rotary

8. Use: __ Domestic __ Public supply __ Industry
__ Irrigation __ Air conditioning __ Stock
__ Lawn X Oil field water __ Other

9. Casing: Material ____ Height: Above ~~or below~~
Threaded ____ Welded ____ Surface 12 in.
RMP ____ PVC X Weight 2.8 lbs./ft.
Dia. 5 in. to 192 ft. depth Wall Thickness: inches or
Dia. ____ in. to ____ ft. depth gage No. sch 40

5. Type and color of material	From	To
Top Soil-Clay	0	90
Clay	90	120
Sandy Clay	120	145
Sand-Clay Stks	145	192
BROCK 192'		
125'		
67 sat thick		
in SP		

(Use a second sheet if needed)

10. Screen: Manufacturer's name Jetstream
Type pvc Dia. 5"
Slot/gauze 1/32" Length 40
Set between 152 ft. and 192 ft.
____ ft. and ____ ft.
Gravel pack? X Size range of material 1/8-3/4"

11. Static water level: mo./day/yr.
125 ft. below land surface Date 3-22-78

12. Pumping level below land surfaces:
____ ft. after ____ hrs. pumping ____ g.p.m.
____ ft. after ____ hrs. pumping ____ g.p.m.
Estimated maximum yield 60 g.p.m.

13. Water sample submitted: mo./day/yr.
__ Yes X No Date ____

14. Well head completion:
__ Pitless adapter 12 Inches above grade

15. Well grouted? X
With: __ Neat cement X Bentonite __ Concrete
Depth: From 0 ft. to 10 ft.

16. Nearest source of possible contamination: oil test
ft. 50 Direction S Type
Well disinfected upon completion? __ Yes X No

17. Pump: X Not installed
Manufacturer's name ____
Model number ____ HP ____ Volts ____
Length of drop pipe ____ ft. capacity ____ g.p.m.
Type:
__ Submersible __ Turbine
__ Jet __ Reciprocating
__ Centrifugal __ Other

18. Elevation:
Topography:
__ Hill
__ Slope
X Upland
__ Valley

19. Remarks:
TOPS
2338
19
2146

20. Water well contractor's certification:
This well was drilled under my jurisdiction and this report is true to the best of my knowledge and belief.
Kellys Waterwell Ser 186
Business name License No.
Address R2 Great Bend, Ks.
Signed Kelly Price Date 9-17-79
Authorized representative

T 30 R 21 W E Sec 11 1/4 1/4 1/4 CNW

Forward the white, blue and pink copies to the Department of Health and Environment

Form WWC-5

MI-1023