USE TYPEWRITER OR BALL POINT PEN-PRESS FIRMLY, PRINT CLEARLY.

Plugging Report

WATER WELL RECORD
KSA 82a-1201-1215

Kansas Department of Health and Environment-Division of Environment
(Water well Contractors)
Topeka, Kansas 66620

1. Location of well:	County	Fraction	Section number	Township number	Range number
	Clark	NE 1/4 SW 1/4 NW 1/4	21	T 30 S	R 21 W E/W

2. Distance and direction from nearest town or city: 8½ miles south of Bucklin, Kansas
Street address of well location if in city:

3. Owner of well: Harlan Kirk
R.R. or street:
City, state, zip code: Bucklin, Kansas 67834

Locate with "X" in section below:

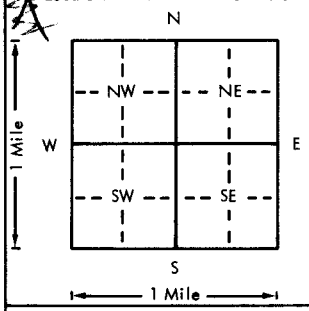

Sketch map:

6. Bore hole dia. XXXX NA in. Completion date
Well depth 151 ft. 3-25-77

7. __ Cable tool __ Rotary __ Driven __ Dug
__ Hollow rod __ Jetted __ Bored __ Reverse rotary

8. Use: __ Domestic __ Public supply __ Industry
__ Irrigation __ Air conditioning X Stock
__ Lawn __ Oil field water __ Other

9. Casing: Material PVC Height: Above or below
Threaded ____ Welded ____ Surface ____ in.
RMP ____ PVC XX Weight ____ lbs./ft.
Dia. 5 in. to 151 ft. depth Wall Thickness: inches or
Dia. ____ in. to ____ ft. depth gage No. ____

5. Type and color of material	From	To
METHOD OF PLUGGING		
filled with sand		
(Use a second sheet if needed)		

10. Screen: Manufacturer's name
Type ____ Dia. ____
Slot/gauze ____ Length ____
Set between ____ ft. and ____ ft.
____ ft. and ____ ft.
Gravel pack? ____ Size range of material ____

11. Static water level: mo./day/yr.
101 ft. below land surface Date

12. Pumping level below land surfaces:
____ ft. after ____ hrs. pumping ____ g.p.m.
____ ft. after ____ hrs. pumping ____ g.p.m.
Estimated maximum yield ____ g.p.m.

13. Water sample submitted: mo./day/yr.
__ Yes __ No Date

14. Well head completion: 3' cement plug
__ Pitless adapter ____ Inches above grade

15. Well grouted? ____
With: __ Neat cement __ Bentonite __ Concrete
Depth: From ____ ft. to ____ ft.

16. Nearest source of possible contamination:
ft. ____ Direction ____ Type ____
Well disinfected upon completion? ____ Yes ____ No

17. Pump: __ Not installed
Manufacturer's name
Model number ____ HP ____ Volts ____
Length of drop pipe ____ ft. capacity ____ g.p.m.
Type:
__ Submersible __ Turbine
__ Jet __ Reciprocating
__ Centrifugal __ Other

18. Elevation:

Topography:
__ Hill
__ Slope
X Upland
__ Valley

19. Remarks:

20. Water well contractor's certification:
This well was drilled under my jurisdiction and this report is true to the best of my knowledge and belief.
Friesen Windmill 252
Business name License No.
Address Meade, Kansas 67864
Signed [signature] Date 2-4-78
Authorized representative

T 30 R 21 (E) W Sec 21 NE 1/4 1/4 1/4

Forward the white, blue and pink copies to the Department of Health and Environment

Form WWC-5

MI-1023