

WATER WELL RECORD Form WWC-5 KSA 82a-1212


1 LOCATION OF WATER WELL: COUNTY: CLARK Fraction SW 1/4 NW 1/4 NW 1/4 Section Number 24 Township Number T 30 S Range Number R 22 W

Distance and direction from nearest town or city street address of well if located within city? 8 MILES SOUTH, 2.75 MILES WEST

2 WATER WELL OWNER: THOROUGHbred & ASSOC RR#, St. Address, Box #: 8100 E. 22ND ST. W. City, State, ZIP code: WICHITA, KS 67226- Board of Agriculture, Division of Water Resources Application Number:

3 LOCATE WELL'S LOCATION WITH AN "X" IN SECTION BOX:

4 DEPTH OF COMPLETED WELL 145 ELEVATION: 0 Depth(s) Groundwater Encountered 1. 95 ft. 2. 0 ft. 3. 0 ft.

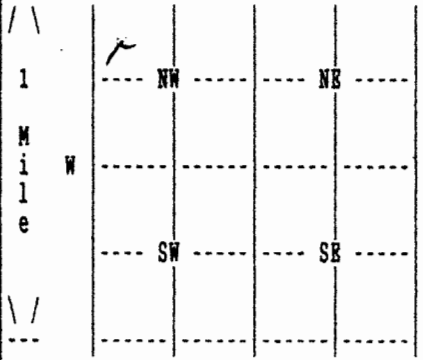

WELL'S STATIC WATER LEVEL 95 ft. below land surface measured on mo/day/yr 01/08/08 Pump test data: Well water was 0 ft. after 0 hours pumping 0 gpm Estimated Yield 0 gpm: Well water was 0 ft. after 0 hours pumping 0 gpm Bore Hole Diameter 8.75 in. to 145 ft., and in. to 0 ft. WELL WATER TO BE USED AS: OIL FIELD Was a chemical/bacteriological sample submitted to department? No; If yes, mo/day/yr sample was submitted Water well disinfected? Yes

5 TYPE OF BLANK CASING USED: PVC CASING JOINTS: GLOUED Blank casing diameter 5 in. to 122 ft., Dia in. to 0 ft., Dia in. to 0 ft. Casing height above land surface 24 in., weight 0 lbs/ft. Wall thickness or gauge No. 26 TYPE OF SCREEN OR PERFORATION MATERIAL: PVC SCREEN OR PERFORATION OPENINGS ARE: SAW CUT

SCREEN PERFORATED INTERVALS: From 122 ft. to 142 ft., From 0 ft. to 0 ft. From 0 ft. to 0 ft., From 0 ft. to 0 ft. GRAVEL PACK INTERVALS: From 25 ft. to 145 ft., From 0 ft. to 0 ft. From 0 ft. to 0 ft., From 0 ft. to 0 ft.

6 GROUT MATERIAL BENTONITE Grout Intervals: From 1 ft. to 25 ft., From 0 ft. to 0 ft., From 0 ft. to 0 ft. What is the nearest source of possible contamination: SEPTIC TANK Direction from well? NORTHEAST How many feet? 1200

Table with columns: FROM, TO, LITHOLOGIC LOG, FROM, TO, PLUGGING INTERVALS. Rows include: 0-4 BROWN CLAY, 4-38 TAN CLAY, 38-86 SAND AND GRAVEL, 86-101 TAN CLAY, 101-110 SAND AND GRAVEL, 110-114 TAN CLAY, 114-138 SAND AND GRAVEL, 138-145 GRAY SHALE.

7 CONTRACTOR'S OR LANDOWNER'S CERTIFICATION: This water well was Constructed under my jurisdiction and was completed on (mo/day/year) 01/08/08 and this record is true to the best of my knowledge and belief. Kansas Water Well Contractor's License No. 653 This Water Well Record was completed on (mo/day/yr) 01/14/08 under the business name of DAN HAYSE WATER WELL SERV by (signature) Dan Hayse